

**SURVEY &  
REMONUMENTATION**

\$7.00  
\$2.00

EAR 08 1999

**LAND CORNER RECORDATION CERTIFICATE**  
Filing Requirement of Act 74, Mich. P.A. 1970  
KENT COUNTY REMONUMENTATION

STATE OF MICHIGAN  
COUNTY OF KENT  
RECEIVED FOR RECORD  
38 DEC 14 AM 8:00  
REG. OF DEEDS  
*Luis S. Bond*

For corners in	<b>SECTION</b>	Located in:	Grattan Township	Corner Code #
Kent (County)				
1. Public Land Survey	T <u>8N</u>	R <u>9W</u>		<u>L-10</u>
	T _____	R _____		_____
	T _____	R _____		_____
	T _____	R _____		_____
2. Property Controlling in Section	S _____	T _____	R _____	_____
	S _____	T _____	R _____	_____
3. Miscellaneous Property in Sec.	S _____	T _____	R _____	_____
	S _____	T _____	R _____	_____
4. Lot No. _____, Recorded Plat _____				
5. Private Claims _____				

**11057**  
Register of Deeds Stamp & File Number

A	B	C	D	E	F	G	H	I	J	K	L	M
2	6	5	4	3	2	1						
3												
4	7	8	9	10	11	12						
5												
6	16	17	16	15	14	13						
7												
8	19	20	21	22	23	24						
9												
10	30	29	28	27	26	25	●					
11												
12	31	32	33	34	35	36						
13												

I, Randy Kolehouse, in a field survey on October 14 19 98, do hereby certify that under requirements of P.A. 74 Michigan P.A. of 1970, the corner points mentioned in lines 1 and 2 above were in conformance with regulations and rules therefore as required in the current manual of survey instructions of the United States Department of the interior, Bureau of Land Management or by a decree of a Court of Law and/or that the corner points mentioned in lines 3, 4 and 5 above were in conformance with the rules of the Michigan Board of Land Surveyors or by a Decree of a Court of Law; established, re-established, monumented, re-monumented, recovered, found as expressed below:

**NOTE: Not more than 4 corners, all in the same town and range, may be recorded on this certificate.**

A. Description of original monument and accessories and/or subsequent restoration:  
L-10 This corner was not originally set by the G.L.O.  
No information on record for this corner.


P.A. 345 1990 KENT COUNTY  
PEER APPROVED 10/22/98  
CHAIRMAN Randy Kolehouse

B. Description of corner evidence found and/or method applied in restoring or reestablishing corner:  
L-10 Set a monument at the intersection of 1/4 lines. Monument is at the corner of fence lines running East, West and North.

The selected location is accepted by me and is generally accepted by professional surveyors as the best available evidence of the position of the original corner.

C. Description of monument for corner and accessories established to perpetuate locating the position of the corner:  
L-10 Set a Standard Kent County Monument

- Nail & K.C. remon. tag on NE side of 5" x 5" fence post N 40° W 4.39'
- Nail & K.C. remon. tag on SE side 14" Maple N 27° W 10.1'
- Nail & K.C. remon. tag on NW side 10" Maple N 04° W 22.6'
- Nail & K.C. remon. tag on Northerly side 8" Elm N 40° E 14.4'
- On corner of fence lines running E-W-N

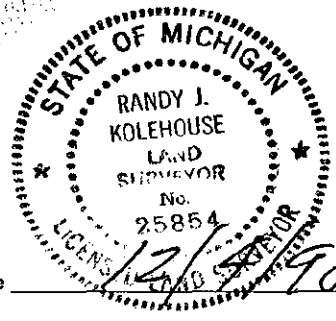

Signed by Randy J. Kolehouse  
EARTH TECH  
Surveyor's Michigan License No. 25854

Date 12/14/98