

7200
7200
SURVEY &
REMONUMENTATION
MAR 08 1999


LAND CORNER RECORDATION CERTIFICATE
Filing Requirement of Act 74, Mich. P.A. 1970
KENT COUNTY REMONUMENTATION

For corners in SECTION
Kent
 (County)

Located in:	Grattan Township	Corner Code #
1. Public Land Survey	T <u>8N</u> R <u>9W</u>	<u>L-11</u>
	T _____ R _____	_____
	T _____ R _____	_____
	T _____ R _____	_____
2. Property Controlling in Section	S _____ T _____ R _____	_____
	S _____ T _____ R _____	_____
3. Miscellaneous Property in Sec.	S _____ T _____ R _____	_____
	S _____ T _____ R _____	_____

STATE OF MICHIGAN
 COUNTY OF KENT
 RECEIVED FOR RECORD
 30 OCT 23 AM 10:00
 REG. OF DEEDS
 10901
 Register of Deeds Stamp & File Number

4. Lot No. _____, Recorded Plat _____
 5. Private Claims _____

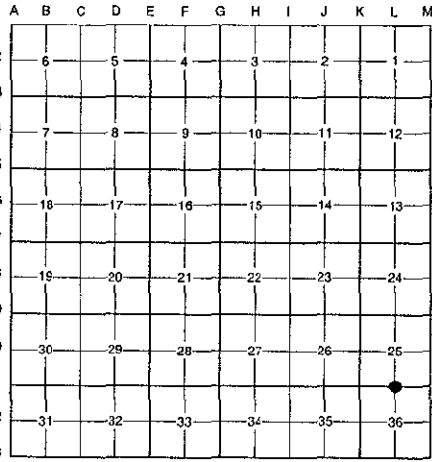

I, Randy Kolehouse, in a field survey on February 27 19 98, do hereby certify that under requirements of P.A. 74 Michigan P.A. of 1970, the corner points mentioned in lines 1 and 2 above were in conformance with regulations and rules therefore as required in the current manual of survey instructions of the United States Department of the Interior, Bureau of Land Management or by a decree of a Court of Law and/or that the corner points mentioned in lines 3, 4 and 5 above were in conformance with the rules of the Michigan Board of Land Surveyors or by a Decree of a Court of Law; established, re-established, monumented, re-monumented, recovered, found as expressed below:

NOTE: Not more than 4 corners, all in the same town and range, may be recorded on this certificate.

A. Description of original monument and accessories and/or subsequent restoration:

L-11	1837	G.L.O. Notes	Cathcart	Set Post
	1978	L.C.R.C. #1133	Medema, Van Kooten & Assoc.	Boat Spike
	1988	L.C.R.C. #4916	C. Marschall	Fnd. Boat Spike / Set K.C. Monument
	1991	L.C.R.C. #5902	William Byl	K.C. Monument

This corner was originally approved by the Kent County Remonumentation Peer Group and monumented by C. Marschall on 11/3/88 and was recorded per L.C.R.C. #4916.

B. Description of corner evidence found and/or method applied in restoring or reestablishing corner:

L-11 Found a Standard Kent County Monument 1' South of the C/L of 5 Mile Road (gravel) running East and West, on line of a tree row running North, per L.C.R.C.'s #4916 and #5902 as set by C. Marschall in place of a boat spike he found which checked L.C.R.C. #1133.

L.C.R.C. #4916

L.C.R.C. #5902


Nail & KC remon tag in NE side 12' hickory S54°E 37.99'	Nail & KC Remon. tag NE side 14" Hickory S54°E 37.99' (m. 38.03')
Nail & KC remon tag in E side 24" hickory 4' high S13°W 34.62'	Nail & KC Remon. tag E. side 24" Hickory (4' high) S13°W 34.68' (m. 34.64')
Nail & KC remon tag in W side 20" hickory N 8°W 29.50'	Nail & KC Remon. tag W. side 24" Hickory N08°W 29.52' (m. 29.59')
Nail & KC remon tag in N side 12" hickory 3' high N60°E 69.00'	Nail & KC Remon. tag N. side 14" Hickory (3' high) N60°E 69.07' (m. 69.04')
	Steel bar & cap (Glaza) S00°W 32.91' (m. 32.92')

The selected location is accepted by me and is generally accepted by professional surveyors as the best available evidence of the position of the original corner.

C. Description of monument for corner and accessories established to perpetuate locating the position of the corner:

L-11 Standard Kent County Monument
 Nail & K.C. remon. tag on NE side 14" Hickory S 54° E 38.03'
 Nail & K.C. remon. tag on E side 24" Hickory S 13° W 34.64'
 Nail & K.C. remon. tag on W side 24" Hickory N 08° W 29.59'
 Nail & K.C. remon. tag on N side 14" Hickory N 60° E 69.04'
 Capped rebar with (Glaza) South 32.92'
 C/L of gravel road running E-W, North 1'
 On tree row running N

P.A. 345 1990 KENT COUNTY
 PEER APPROVED 6/25/98
 CHAIRMAN *[Signature]*

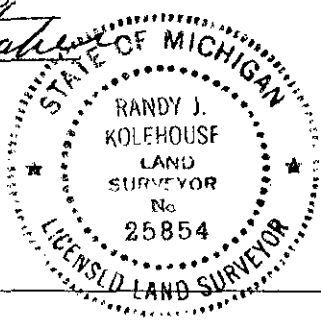

Signed by *Randy J. Kolehouse* Date 9-1-98
 EARTH TECH
 Surveyor's Michigan License No. 25854