

\$7.00  
\$2.00

MAR 08 1999

**LAND CORNER RECORDATION CERTIFICATE**  
**Filing Requirement of Act 74, Mich. P.A. 1970**  
**KENT COUNTY REMONUMENTATION**

SECTION

For corners in

Kent (County)	Located in:	Grattan Township	Corner Code #
1. Public Land Survey	T <u>8N</u>	R <u>9W</u>	<u>L-12</u>
	T _____	R _____	_____
	T _____	R _____	_____
	T _____	R _____	_____
2. Property Controlling in Section	S _____	T _____	R _____
	S _____	T _____	R _____
3. Miscellaneous Property in Sec.	S _____	T _____	R _____
	S _____	T _____	R _____

STATE OF MICHIGAN  
 COUNTY OF KENT  
 RECEIVED FOR RECORD  
 38 DEC 14 AM 8:00  
 REG. OF DEEDS  
*Lucy Standa*

**11058**

Register of Deeds Stamp & File Number

4. Lot No. \_\_\_\_\_, Recorded Plat \_\_\_\_\_  
 5. Private Claims \_\_\_\_\_

I, Randy Kolehouse, in a field survey on December 4 19 98, do hereby certify that under requirements of P.A. 74 Michigan P.A. of 1970, the corner points mentioned in lines 1 and 2 above were in conformance with regulations and rules therefore as required in the current manual of survey instructions of the United States Department of the Interior, Bureau of Land Management or by a decree of a Court of Law and/or that the corner points mentioned in lines 3, 4 and 5 above were in conformance with the rules of the Michigan Board of Land Surveyors or by a Decree of a Court of Law; established, re-established, monumented, re-monumented, recovered, found as expressed below:

	A	B	C	D	E	F	G	H	I	J	K	L	M
2	6		5		4		3		2		1		
3													
4	7		8		9		10		11		12		
5													
6	18		17		16		15		14		13		
7													
8	19		20		21		22		23		24		
9													
10	30		29		28		27		26		25		
11													
12	31		32		33		34		35				
13													

**NOTE: Not more than 4 corners, all in the same town and range, may be recorded on this certificate.**


A. Description of original monument and accessories and/or subsequent restoration:  
 L-12 This corner was not originally set by the G.L.O.  
 No information on record for this corner.

P.A. 345 1990 KENT COUNTY  
 PEER APPROVED 11/12/98  
 CHAIRMAN *Randy Kolehouse*

B. Description of corner evidence found and/or method applied in restoring or reestablishing corner:  
 L-12 Set a monument at the intersection of 1/4 lines. Monument is 100' ± South of railroad tracks running East and West and 250' East of line of woods running South.

The selected location is accepted by me and is generally accepted by professional surveyors as the best available evidence of the position of the original corner.

C. Description of monument for corner and accessories established to perpetuate locating the position of the corner:  
 L-12 Set a Standard Kent County Monument  
 Nail & K.C. remon. tag on SE'ly side 6" Maple N 30° E 55.79'  
 Nail & K.C. remon. tag on E side 8" Maple N 12° W 55.77'  
 Nail & K.C. remon. tag on W'ly side 10" Cherry N 43° W 60.87'  
 Nail & K.C. remon. tag on SE'ly side 8" Maple N 66° W 88.51'  
 Railroad tracks running E-W, North 100' ±  
 Line of woods running S, West 250'

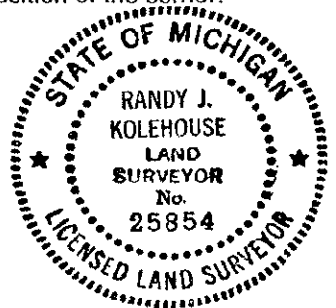

Signed by *Randy J. Kolehouse* Date 12/5/98  
 EARTH TECH  
 Surveyor's Michigan License No. 25854