

\$7.00
\$2.00

DEC 08 1999

LAND CORNER RECORDATION CERTIFICATE
Filing Requirement of Act 74, Mich. P.A. 1970
KENT COUNTY REMONUMENTATION

STATE OF MICHIGAN
COUNTY OF KENT
RECEIVED FOR RECORD
98 DEC 14 AM 8:00
REG. OF DEEDS
Lucy Standa

For corners in

SECTION

Kent (County)	Located in:	Grattan Township	Corner Code #
1. Public Land Survey	T <u>8N</u>	R <u>9W</u>	<u>M-5</u>
	T _____	R _____	_____
	T _____	R _____	_____
	T _____	R _____	_____
2. Property Controlling in Section	S _____	T _____	R _____
	S _____	T _____	R _____
3. Miscellaneous Property in Sec.	S _____	T _____	R _____
	S _____	T _____	R _____

11009

Register of Deeds Stamp & File Number

4. Lot No. _____, Recorded Plat _____
5. Private Claims _____

I, Randy Kolehouse, in a field survey on January 29 19 98, do hereby certify that under requirements of P.A. 74 Michigan P.A. of 1970, the corner points mentioned in lines 1 and 2 above were in conformance with regulations and rules therefore as required in the current manual of survey instructions of the United States Department of the interior, Bureau of Land Management or by a decree of a Court of Law and/or that the corner points mentioned in lines 3, 4 and 5 above were in conformance with the rules of the Michigan Board of Land Surveyors or by a Decree of a Court of Law; established, re-established, monumented, re-monumented, recovered, found as expressed below:

	A	B	C	D	E	F	G	H	I	J	K	L	M
2	6	5	4	3	2	1							
3													
4	7	8	9	10	11	12							
5													
6	18	17	16	15	14	13							
7													
8	19	20	21	22	23	24							
9													
10	30	29	28	27	26	25							
11													
12	31	32	33	34	35	36							

NOTE: Not more than 4 corners, all in the same town and range, may be recorded on this certificate.

A. Description of original monument and accessories and/or subsequent restoration:

M-5	1837	G.L.O. Notes	N. Brookfield	18" Oak
	1965	Records	M.D.S.H.	1/4" Iron in 1-1/4" Iron
	1985	L.C.R.C. #4191	R. Kolehouse	Fnd. Boat Spike / Set K.C. Monument
	1991	L.C.R.C. #5907	William Byl	K.C. Monument

P.A. 345 1990 KENT COUNTY
PEER APPROVED 9/29/98
CHAIRMAN [Signature]

Note: This corner is common with A-5, T8N, R8W.

This corner was originally approved by the Kent County Remonumentation Peer Group and monumented by Randy Kolehouse on 3/9/85 and was recorded per L.C.R.C. #4191.

B. Description of corner evidence found and/or method applied in restoring or reestablishing corner:

M-5 Found a Standard Kent County Monument (4" below ground) on the C/L of Montcalm Avenue (gravel) running North and South and 160' ± North of the C/L of M-44 (bit.) running East and West per L.C.R.C.'s #4191 and #5907 as set by Randy Kolehouse in place of a boat spike he found which checked M.D.S.H. records.

L.C.R.C. #4191

L.C.R.C. #5907

Nail & K.C. Remon. tag in N. side 12" Oak N 72° W 39.95'
Nail & K.C. Remon. tag in W. side 10" Oak N 20° E 133.65'
Nail & K.C. Remon. tag in top C/L 18" C.M.P. culv. S 25° W 89.7'
Top cor. "L" fence post (steel) N 65° E 41.20'


Nail & KC Remon. tag N. side Tw. 18" Oak N72°W 39.97' (m. 39.82')
Nail & KC Remon. tag W. side 12" Oak N20° E 133.43'
Nail & KC Remon. tag top C/L 18" CMP culv. S25°W 89.72'
Top cor. "L" fence post (steel) N65°E 41.15'
C/L M-44 S00°E 161'

The selected location is accepted by me and is generally accepted by professional surveyors as the best available evidence of the position of the original corner.

C. Description of monument for corner and accessories established to perpetuate locating the position of the corner:

M-5 Standard Kent County Monument

Nail & K.C. remon. tag on N side twin 18" Oak N 72° W 39.82'
Nail & K.C. remon. tag on W side 12" Oak N 20° E 133.43'
Nail & K.C. remon. tag on top C/L 18" CMP culv. S 25° W 89.72'
Top cor. "L" fence post (steel) N 65° E 41.15'
On C/L of gravel road running N-S
C/L of M-44 running E-W, South 160' ±

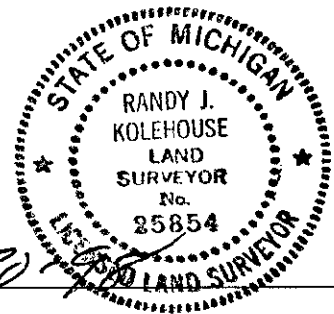

Signed by Randy J. Kolehouse Date 9-30-98

Surveyor's Michigan License No. 25854