

DEC 8 1999

\$7.00  
\$2.00

SECTION

LAND CORNER RECORDATION CERTIFICATE  
Filing Requirement of Act 74, Mich. P.A. 1970  
KENT COUNTY REMONUMENTATION

For corners in

Kent (County)	Located in: Grattan Township	Corner Code #
1. Public Land Survey	T <u>8N</u> R <u>9W</u>	<u>M-6</u>
	T _____ R _____	_____
	T _____ R _____	_____
	T _____ R _____	_____
2. Property Controlling in Section	S _____ T _____ R _____	_____
	S _____ T _____ R _____	_____
3. Miscellaneous Property in Sec.	S _____ T _____ R _____	_____
	S _____ T _____ R _____	_____

STATE OF MICHIGAN  
COUNTY OF KENT  
RECEIVED FOR RECORD  
38 DEC 14 AM 8:00  
REG. OF DEEDS  
*Lucy Hand*

11010

Register of Deeds Stamp & File Number

4. Lot No. \_\_\_\_\_, Recorded Plat \_\_\_\_\_  
5. Private Claims \_\_\_\_\_

I, Randy Kolehouse, in a field survey on January 29 19 98, do hereby certify that under requirements of P.A. 74 Michigan P.A. of 1970, the corner points mentioned in lines 1 and 2 above were in conformance with regulations and rules therefore as required in the current manual of survey instructions of the United States Department of the interior, Bureau of Land Management or by a decree of a Court of Law and/or that the corner points mentioned in lines 3, 4 and 5 above were in conformance with the rules of the Michigan Board of Land Surveyors or by a Decree of a Court of Law; established, re-established, monumented, re-monumented, recovered, found as expressed below:

**NOTE:** Not more than 4 corners, all in the same town and range, may be recorded on this certificate.

A. Description of original monument and accessories and/or subsequent restoration:

M-6	1837	G.L.O. Notes	N. Brookfield	Set Post
	1965	Witness Map	K.C. Surveyor	1/2" Iron Pipe
	N/A	Notes	Nederveld & Assoc.	Boat Spike
	1985	L.C.R.C. #4192	R. Kolehouse	Fnd. Boat Spike / Set K.C. Monument
	1991	L.C.R.C. #5903	William Byl	Replaced K.C. Monument

A	B	C	D	E	F	G	H	I	J	K	L	M
2	6	5	4	3	2	1						
3												
4	7	8	3	10	11	12						
5												
6	18	17	16	15	14	13						
7												
8	19	20	21	22	23	24						
9												
10	30	29	28	27	26	25						
11												
12	31	32	33	34	35	36						
13												

Note: This corner is common with A-6, T8N, R8W.

This corner was originally approved by the Kent County Remonumentation Peer Group and monumented by Randy Kolehouse on 3/9/85 and was recorded per L.C.R.C. #4192.


B. Description of corner evidence found and/or method applied in restoring or reestablishing corner:

M-6	Found a Standard Kent County Monument on the C/L of Montcalm Avenue (gravel) running North and South and 25' ± North of a fence line running West per L.C.R.C.'s #4192 and #5903 as set by Randy Kolehouse in place of a boat spike he found which checked witnesses of Nederveld & Assoc.	
	L.C.R.C. #4192	L.C.R.C. #5908
	Nail & K.C. Remon. tag in W. side 14" Hickory N 30° E 69.73'	Nail & KC Remon. tag W. side 14" Hickory N30°E 69.65' (m. 69.87')
	Nail & K.C. Remon. tag in NW side 14" Hickory N 45° E 39.45'	Nail & KC Remon. tag NW side 14" Hickory N45°E 39.45' (m. 39.65')
	Nail & K.C. Remon. tag in NE side 1" dia. wood fe. Post N 45° W 45.7'	Nail & KC Remon. tag NE side 1" dia. wood post N45°W 44.22' (m. 44.28')
	Nail & MSHD tag in N. side 14" Hickory S 80° E 56.0'	Nail & KC Remon. tag N. side 14" Hickory S80°E 56.00' (m. 56.12')
		Nail & KC Remon. tg E. side 8" Aspen S25°W 47.04' (m. 46.86')

The selected location is accepted by me and is generally accepted by professional surveyors as the best available evidence of the position of the original corner.

C. Description of monument for corner and accessories established to perpetuate locating the position of the corner:

M-6	Standard Kent County Monument
	Nail & K.C. remon. tag on W side 14" Hickory N 30° E 69.87'
	Nail & K.C. remon. tag on NW side 14" Hickory N 45° E 39.65'
	Nail & K.C. remon. tag on NE side 1" dia. wood post N 45° W 44.28'
	Nail & K.C. remon. tag on N side 14" Hickory S 80° E 56.12'
	Nail & K.C. remon. tag on E side 8" Aspen S 25° W 46.86'
	On C/L of gravel road running N-S
	Fence line running W, South 25'

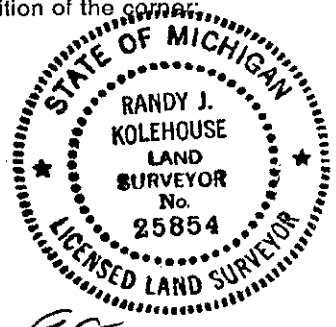

Signed by Randy J. Kolehouse Date 9-30-98  
EARTH TECH  
Surveyor's Michigan License No. 25854