

DAR 08 1999

SECTION

LAND CORNER RECORDATION CERTIFICATE
Filing Requirement of Act 74, Mich. P.A. 1970
KENT COUNTY REMONUMENTATION

For corners in

Table with columns: Kent (County), Located in: Grattan Township, Corner Code #. Rows include Public Land Survey, Property Controlling in Section, and Miscellaneous Property in Sec.

REG. OF DEEDS

Handwritten signature/initials

38 OCT 23 AM 10:00


STATE OF MICHIGAN
COUNTY OF KENT
RECEIVED FOR RECORD

10902

Register of Deeds Stamp & File Number

- 4. Lot No. , Recorded Plat
5. Private Claims

I, Randy Kolehouse, in a field survey on February 3, 1998, do hereby certify that under requirements of P.A. 74 Michigan P.A. of 1970, the corner points mentioned in lines 1 and 2 above were in conformance with regulations and rules therefore as required in the current manual of survey instructions of the United States Department of the interior, Bureau of Land Management or by a decree of a Court of Law and/or that the corner points mentioned in lines 3, 4 and 5 above were in conformance with the rules of the Michigan Board of Land Surveyors or by a Decree of a Court of Law; established, re-established, monumented, re-monumented, recovered, found as expressed below:

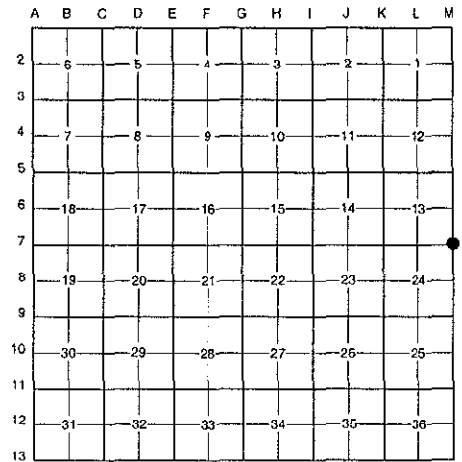

NOTE: Not more than 4 corners, all in the same town and range, may be recorded on this certificate.

A. Description of original monument and accessories and/or subsequent restoration:

Table with 4 columns: Corner Code (M-7), Date (1837, 1977, 1981, 1991), Description (G.L.O. Notes, L.C.R.C. #994, #1974, #5909), Name (N. Brookfield, Medema, Van Kooten & Assoc., Jonker Land Survey, William Byl), and Monument Type (Set Post, 3/4" Iron, Fnd. 3/4" Iron / Set K.C. Monument, K.C. Monument).

Note: This corner is common with A-7, T8N, R8W.

This corner was originally approved by the Kent County Remonumentation Peer Group and monumented by Rob Jonker on 6/16/81 and was recorded per L.C.R.C. #1974.

B. Description of corner evidence found and/or method applied in restoring or reestablishing corner:

M-7 Found a Standard Kent County Monument 2' East of the C/L of Montcalm Road (gravel) running North and South and 2' South of the C/L of 7 Mile Road (gravel) running West per L.C.R.C.'s #1974 and #5909 as set by Rob Jonker in place of a 3/4" round iron he found which checked L.C.R.C. #994.

L.C.R.C. #1974

L.C.R.C. #5909

Remon. tag on E side 14" W. Cherry N5°W 132.12'
Remon. tag on N side p. pole S75°E 32.75'

Nail & KC Remon tag E. side 14" Stump N05°W 132.23' (m. 132.24')
Nail & KC Remon tag N. side P. Pole S75°E 32.69'
Nail & KC Remon. tag E. side 12" Oak S30°W 75.65'


The selected location is accepted by me and is generally accepted by professional surveyors as the best available evidence of the position of the original corner.

C. Description of monument for corner and accessories established to perpetuate locating the position of the corner:

M-7 Standard Kent County Monument

- Nail & K.C. remon. tag on E side 14" stump N 05° W 132.24' P.A. 345 1990 KENT COUNTY
Nail & K.C. remon. tag on N side P. pole S 75° E 32.69'
Nail & K.C. remon. tag on E side 12" Oak S 30° W 75.65'
Nail & K.C. remon. tag on SW side 6" Oak S 25° E 31.99'
Top C/L MBT box N 56° E 41.50'
C/L of gravel road running N-S, West 2'
C/L of gravel road running W, North 2'

PEER APPROVED 6/25/98
CHAIRMAN [Signature]

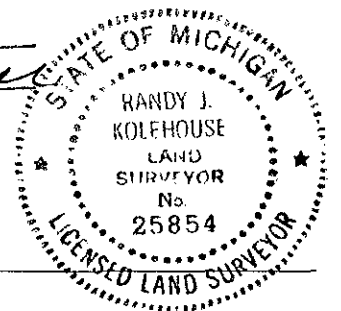

Signed by [Signature] EARTH TECH

Date 9-1-98

Surveyor's Michigan License No. 25854