

\$7.00
\$2.00

MAR 08 1999

LAND CORNER RECORDATION CERTIFICATE

Filing Requirement of Act 74, Mich. P.A. 1970

KENT COUNTY REMONUMENTATION

For corners in SECTION

Kent (County)	Located in:	Grattan Township	Corner Code #
1. Public Land Survey	T <u>8N</u>	R <u>9W</u>	<u>M-8</u>
	T _____	R _____	_____
	T _____	R _____	_____
	T _____	R _____	_____
2. Property Controlling in Section	S _____	T _____	R _____
	S _____	T _____	R _____
3. Miscellaneous Property in Sec.	S _____	T _____	R _____
	S _____	T _____	R _____

STATE OF MICHIGAN
COUNTY OF KENT
RECEIVED FOR RECORDS
38 OCT 23 AM 10:00
REG. OF DEEDS
Luci Standa
10903

Register of Deeds Stamp & File Number

4. Lot No. _____, Recorded Plat _____
5. Private Claims _____

	A	B	C	D	E	F	G	H	I	J	K	L	M
2	6		5		4		3		2		1		
3													
4	7		8		9		10		11		12		
5													
6	18		17		16		15		14		13		
7													
8	19		20		21		22		23		24		
9													
10	30		29		28		27		26		25		
11													
12	31		32		33		34		35		36		
13													

I, Randy Kolehouse, in a field survey on February 3 19 98, do hereby certify that under requirements of P.A. 74 Michigan P.A. of 1970, the corner points mentioned in lines 1 and 2 above were in conformance with regulations and rules therefore as required in the current manual of survey instructions of the United States Department of the interior, Bureau of Land Management or by a decree of a Court of Law and/or that the corner points mentioned in lines 3, 4 and 5 above were in conformance with the rules of the Michigan Board of Land Surveyors or by a Decree of a Court of Law; established, re-established, monumented, re-monumented, recovered, found as expressed below:

NOTE: Not more than 4 corners, all in the same town and range, may be recorded on this certificate.

A. Description of original monument and accessories and/or subsequent restoration:

M-8	1837	G.L.O. Notes	N. Brookfield	Set Post
	1977	L.C.R.C. #994	Medema, Van Kooten & Assoc.	Set Capped 1/2" Rod
	1985	L.C.R.C. #4193	R. Kolehouse	Fnd. Capped Iron / Set K.C. Monument
	1990	L.C.R.C. #5910	William Byl	K.C. Monument

Note: This corner is common with A-8, T8N, R8W.

This corner was originally approved by the Kent County Remonumentation Peer Group and monumented by Randy Kolehouse on 3/9/85 and was recorded per L.C.R.C. #4193.

B. Description of corner evidence found and/or method applied in restoring or reestablishing corner:

M-8 Found a Standard Kent County Monument on the C/L of Montcalm Avenue (gravel) running North and South per L.C.R.C.'s #4193 and #5910 as set by Randy Kolehouse in place of a M.V.K. capped iron he found which checked L.C.R.C. #994.

L.C.R.C. #4193

L.C.R.C. #5910

Nail & K.C. Remon. tag in E. side 12" Apple N 20° W 60.92'
Nail & K.C. Remon. tag in W. side 10" Elm S 35° W 35.16'
Nail & K.C. Remon. tag in W. side 6" Hickory S 22° E 50.04'
Nail & K.C. Remon. tag in SW side Tri. 6" Elm S 80° E 22.22'

Nail & KC Remon. tag E. side 14" Apple N20°W 61.00' (m. 60.95')
Nail & KC Remon. tag W. side 15" Elm S35°W 35.15' (m. 35.13')
Nail & KC Remon. tag W. side 8" Hickory S22°E 50.01'(m. 50.07')
Nail & KC Remon. tag SW side Tri. 6" Elm S80°E 22.22' (m. 22.15')

The selected location is accepted by me and is generally accepted by professional surveyors as the best available evidence of the position of the original corner.

C. Description of monument for corner and accessories established to perpetuate locating the position of the corner:


M-8 Standard Kent County Monument

Nail & K.C. remon. tag on E side 14" Apple N 20° W 60.95'
Nail & K.C. remon. tag on W side 15" Elm S 35° W 35.13'
Nail & K.C. remon. tag on W side 8" Hickory S 22° E 50.07'
Nail & K.C. remon. tag on SW side Tri. 6" Elm S 80° E 22.15'
On C/L of gravel road running N-S

P.A. 345 1990 KENT COUNTY

PEER APPROVED 6/25/98

CHAIRMAN *Randy Kolehouse*

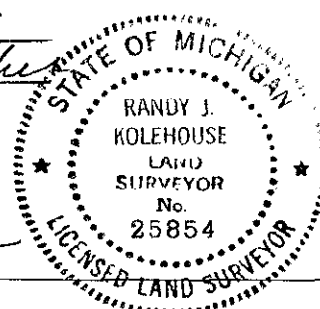

Signed by Randy J. Kolehouse Date 9-1-98

EARTH TECH

Surveyor's Michigan License No. 25854