

MAR 08 1999

\$7.00
\$2.00

SECTION

LAND CORNER RECORDATION CERTIFICATE
Filing Requirement of Act 74, Mich. P.A. 1970
KENT COUNTY REMONUMENTATION

For corners in

Kent (County)	Located in: Grattan Township	Corner Code #
1. Public Land Survey	T <u>8N</u> R <u>9W</u>	<u>M-10</u>
	T _____ R _____	_____
	T _____ R _____	_____
	T _____ R _____	_____
2. Property Controlling in Section	S _____ T _____ R _____	_____
	S _____ T _____ R _____	_____
3. Miscellaneous Property in Sec.	S _____ T _____ R _____	_____
	S _____ T _____ R _____	_____

STATE OF MICHIGAN
COUNTY OF KENT
RECEIVED FOR RECORD

38 OCT 23 AM 10:00

REG. OF DEEDS
Lucy Stand

10904

Register of Deeds Stamp & File Number

- 4. Lot No. _____, Recorded Plat _____
- 5. Private Claims _____

A	B	C	D	E	F	G	H	I	J	K	L	M
2	6	5	4	3	2	1						
3												
4	7	8	9	10	11	12						
5												
6	18	17	16	15	14	13						
7												
8	19	20	21	22	23	24						
9												
10	30	29	28	27	26	25						
11												
12	31	32	33	34	35	36						
13												

I, Randy Kolehouse, in a field survey on February 3 19 98, do hereby certify that under requirements of P.A. 74 Michigan P.A. of 1970, the corner points mentioned in lines 1 and 2 above were in conformance with regulations and rules therefore as required in the current manual of survey instructions of the United States Department of the interior, Bureau of Land Management or by a decree of a Court of Law and/or that the corner points mentioned in lines 3, 4 and 5 above were in conformance with the rules of the Michigan Board of Land Surveyors or by a Decree of a Court of Law; established, re-established, monumented, re-monumented, recovered, found as expressed below:

NOTE: Not more than 4 corners, all in the same town and range, may be recorded on this certificate.

A. Description of original monument and accessories and/or subsequent restoration:

M-10 1837	G.L.O. Notes	N. Brookfield	Set Post
1984	L.C.R.C. #3759	R. Kolehouse	Set R.R. Spike / Set K.C. Monument
1990	L.C.R.C. #5912	William Byl	K.C. Monument

Note: This corner is common with A-10, T8N, R8W.

This corner was originally approved by the Kent County Remonumentation Peer Group and monumented by Randy Kolehouse in February of 1984 and was recorded per L.C.R.C. #3759.

B. Description of corner evidence found and/or method applied in restoring or reestablishing corner:

M-10 Found a Standard Kent County Monument 3' East of the C/L of Montcalm Avenue (gravel) running North and South, on line of a fence line running West and a tree row running East, per L.C.R.C.'s #3759 and #5912 as set by Randy Kolehouse.

L.C.R.C. #3759

L.C.R.C. #5912

- Nail & K.C. Remon. tag in N. side twin 24" Oak N 80 E 30.65'
- Nail & K.C. Remon. tag in W. side 24" Beech N 30 E 44.15'
- Nail & K.C. Remon. tag in S. side 28" Oak S 85 W 32.42'
- Nail & K.C. Remon. tag in SE side 12" Maple S 45 W 43.39'
- Nail & K.C. Remon. tag in W. side 12" Walnut S 10 E 58.32'

- Nail & KC Remon. tag N. side 30" Oak N80°E 30.62' (m. 30.60')
- Nail & KC Remon. tag W. side 27" Beech N30°E 44.17' (m. 44.18')
- Nail & KC Remon. tag S. side 28" Oak S85°W 38.44'
- Nail & KC Remon. tag SE side 27" Maple S45°W 43.38' (m. 43.39')
- Nail & KC Remon. tag W. side 16" Walnut S10°E 58.38' (m. 58.41')

The selected location is accepted by me and is generally accepted by professional surveyors as the best available evidence of the position of the original corner.


C. Description of monument for corner and accessories established to perpetuate locating the position of the corner:

M-10 Standard Kent County Monument

P.A. 345 1990 KENT COUNTY

PEER APPROVED 6/25/98
CHAIRMAN Randy Kolehouse

- Nail & K.C. remon. tag on N side 30" Oak N 80° E 30.60'
- Nail & K.C. remon. tag on W side 27" Beech N 30° E 44.18'
- Nail & K.C. remon. tag on S side 30" Oak S 85° W 38.44'
- Nail & K.C. remon. tag on SE side 27" Maple S 45° W 43.39'
- Nail & K.C. remon. tag on W side 18" Walnut S 10° E 58.41'
- C/L of gravel road running N-S, West 3'
- On fence line running W
- On tree row running E

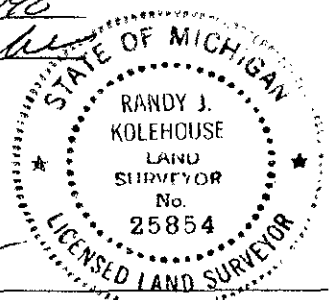

Signed by Randy Kolehouse Date 9-1-98
EARTH TECH

Surveyor's Michigan License No. 25854