

37.00
\$2.00
MAR 08 1999

LAND CORNER RECORDATION CERTIFICATE
Filing Requirement of Act 74, Mich. P.A. 1970
KENT COUNTY REMONUMENTATION

For corners in SECTION

| | | |
|---------------------------------------|------------------------------|---------------|
| <u>Kent</u> (County) | Located in: Grattan Township | Corner Code # |
| 1. Public Land Survey | T <u>8N</u> R <u>9W</u> | <u>M-11</u> |
| | T _____ R _____ | _____ |
| | T _____ R _____ | _____ |
| | T _____ R _____ | _____ |
| 2. Property Controlling in Section | S _____ T _____ R _____ | _____ |
| | S _____ T _____ R _____ | _____ |
| 3. Miscellaneous Property in Sec. | S _____ T _____ R _____ | _____ |
| | S _____ T _____ R _____ | _____ |
| 4. Lot No. _____, Recorded Plat _____ | | |
| 5. Private Claims _____ | | |

STATE OF MICHIGAN
 COUNTY OF KENT
 RECEIVED FOR RECORD
 98 OCT 23 AM 10:00
 REG. OF DEEDS
Lucy St. Paul


10905
 Register of Deeds Stamp & File Number

I, Randy Kolehouse, in a field survey on February 3 19 98, do hereby certify that under requirements of P.A. 74 Michigan P.A. of 1970, the corner points mentioned in lines 1 and 2 above were in conformance with regulations and rules therefore as required in the current manual of survey instructions of the United States Department of the interior, Bureau of Land Management or by a decree of a Court of Law and/or that the corner points mentioned in lines 3, 4 and 5 above were in conformance with the rules of the Michigan Board of Land Surveyors or by a Decree of a Court of Law; established, re-established, monumented, re-monumented, recovered, found as expressed below:

NOTE: Not more than 4 corners, all in the same town and range, may be recorded on this certificate.

A. Description of original monument and accessories and/or subsequent restoration:

| | | | | |
|------|------|----------------|---------------|-----------------------------------|
| M-11 | 1837 | G.L.O. Notes | N. Brookfield | Set Post |
| | N/A | Witness Map | K.C. Surveyor | 1" Iron and Stone |
| | 1984 | L.C.R.C. #3757 | R. Kolehouse | Fnd. Iron Bar / Set K.C. Monument |
| | 1991 | L.C.R.C. #5913 | William Byl | K.C. Monument |

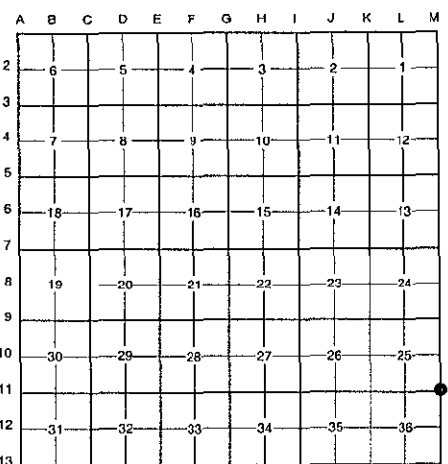

Note: This corner is common with A-11, T8N, R8W.

This corner was originally approved by the Kent County Remonumentation Peer Group and monumented by Randy Kolehouse in February 1984 and was recorded per L.C.R.C. #3757.

P.A. 345 1990 KENT COUNTY
 PEER APPROVED 6/25/98
 CHAIRMAN *Henry Miller*

B. Description of corner evidence found and/or method applied in restoring or reestablishing corner:

M-11 Found a Standard Kent County Monument on the C/L of Montcalm Avenue (gravel) running North and South and on the North line of 5 Mile Road (gravel) running East and West per L.C.R.C.'s #3757 and #5913 as set by Randy Kolehouse in place of a 1-1/2" x 1-1/2" iron bar he found which checked the K.C. Surveyor's records.

| | |
|-------------------------------------------------------------|----------------------------------------------------------------|
| L.C.R.C. #3757 | L.C.R.C. #5913 |
| Nail & K.C. Remon. tag in NW side 40' Walnut N 80 E 29.82' | Nail & KC Remon. tag W. Tri. 6" Maple N30°W 63.54' (m. 63.38') |
| Nail & K.C. Remon. tag in W. side Tri. 6" Oak N 30 W 63.46' | Nail & KC Remon. tag E. side 14" Hickory S25°W 64.38' |
| Nail & K.C. Remon. tag in E. side 12" Hickory S 25 W 64.40' | Nail & KC Remon. tag NE side P. Pole N75°W 41.68' (m. 41.65') |
| Nail & K.C. Remon. tag in NE side P.Pole N 75 W 41.58' | |


The selected location is accepted by me and is generally accepted by professional surveyors as the best available evidence of the position of the original corner.

C. Description of monument for corner and accessories established to perpetuate locating the position of the corner:

M-11 Standard Kent County Monument

- Nail & K.C. remon. tag on W side tri. 8" Maple N 30° W 63.38'
- Nail & K.C. remon. tag on NE side P. pole N 75° W 41.65'
- Nail & K.C. remon. tag on E side 14" Hickory S 25° W 64.38'
- Nail & K.C. remon. tag on S side twin 6" Hickory N 75° E 46.91'
- Nail & K.C. remon. tag on W side 12" Pine S 25° E 82.16'
- On C/L of gravel road running N-S
- On North line of gravel road running E-W

Signed by *Randy J. Kolehouse* Date 9-1-98
 EARTH TECH

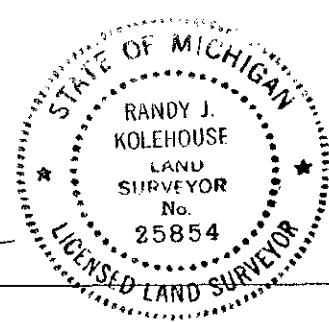

Surveyor's Michigan License No. 25854