

\$7.00
\$2.00

SURVEY &
REMONUMENTATION

MAR 08 1999

LAND CORNER RECORDATION CERTIFICATE
Filing Requirement of Act 74, Mich. P.A. 1970
KENT COUNTY REMONUMENTATION

STATE OF MICHIGAN
COUNTY OF KENT
RECEIVED FOR RECORD
38 DEC 14 AM 8:00
REG. OF DEEDS
Lucy Board

For corners in SECTION
Kent
(County)

Located in: Grattan Corner Code #
Township

- 1. Public Land Survey T 8N R 9W M-12
T _____ R _____
T _____ R _____
T _____ R _____
- 2. Property Controlling S _____ T _____ R _____
in Section S _____ T _____ R _____
- 3. Miscellaneous S _____ T _____ R _____
Property in Sec. S _____ T _____ R _____

11012

Register of Deeds Stamp & File Number

- 4. Lot No. _____, Recorded Plat _____
- 5. Private Claims _____

	A	B	C	D	E	F	G	H	I	J	K	L	M
2	6		5		4		3		2		1		
3													
4	7		8		9		10		11		12		
5													
6	18		17		16		15		14		13		
7													
8	19		20		21		22		23		24		
9													
10	30		29		28		27		26		25		
11													
12	31		32		33		34		35		36		

I, Randy Kolehouse, in a field survey on February 3 19 98, do hereby certify that under requirements of P.A. 74 Michigan P.A. of 1970, the corner points mentioned in lines 1 and 2 above were in conformance with regulations and rules therefore as required in the current manual of survey instructions of the United States Department of the interior, Bureau of Land Management or by a decree of a Court of Law and/or that the corner points mentioned in lines 3, 4 and 5 above were in conformance with the rules of the Michigan Board of Land Surveyors or by a Decree of a Court of Law; established, re-established, monumented, re-monumented, recovered, found as expressed below:

NOTE: Not more than 4 corners, all in the same town and range, may be recorded on this certificate.

A. Description of original monument and accessories and/or subsequent restoration:

M-12	1837	G.L.O. Notes	N. Brookfield	Set Post
	N/A	Witness Map	K.C. Surveyor	N/A
	1978	L.C.R.C. #1134	Medema, Van Kooten & Assoc.	Plow Point
	1981	L.C.R.C. #2024	Jonker Land Survey	Fnd. Flat iron / Set K.C. Monument
	1991	L.C.R.C. #5914	William Byl	K.C. Monument

P.A. 345 1990 KENT COUNTY
PEER APPROVED 9/24/98
CHAIRMAN [Signature]

Note: This corner is common with A-12, T8N, R8W.


This corner was originally approved by the Kent County Remonumentation Peer Group and monumented by Rob Jonker on 6/16/81 and was recorded per L.C.R.C. #2024.

B. Description of corner evidence found and/or method applied in restoring or reestablishing corner:
M-12 Found a Standard Kent County Monument 3' East of the C/L of Montcalm Avenue (gravel) running North and South on the C/L of a field entrance running East per L.C.R.C.'s #2024 and #5914 as set by Rob Jonker in place of a 5/8"x2-1/2"x14" flat iron he found which checked L.C.R.C. #1134.

L.C.R.C. #2024	L.C.R.C. #5914
Remon. tag on NE side 16" Oak N30°W 38.71'	Nail & KC Remon. tag NE side 18" Oak N30°W 38.81' (m. 38.75')
Remon. tag on W side 6" Elm S19°E 27.87'	Nail & KC Remon. tag W. side 12" Elm S19°E 27.84'

The selected location is accepted by me and is generally accepted by professional surveyors as the best available evidence of the position of the original corner.

C. Description of monument for corner and accessories established to perpetuate locating the position of the corner:
M-12 Standard Kent County Monument
Nail & K.C. remon. tag on W side 14" Elm S 19° E 27.84'
Nail & K.C. remon. tag on NE side 18" Oak stump N 30° W 38.75'
Nail & K.C. remon. tag on SE side 14" Oak S 49° W 40.68'
Nail & K.C. remon. tag on N side twin 18" Oak N 70° W 31.95'
Nail & K.C. remon. tag on W side 12" Maple N 10° E 51.78'
C/L of gravel road running N-S, West 3'

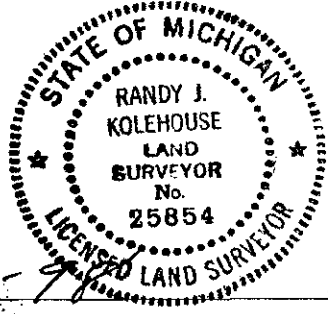

Signed by Randy J. Kolehouse Date 9-30-98
EARTH TECH

Surveyor's Michigan License No. 25854