

SURVEY & REMONUMENTATION

MAR 08 1999

LAND CORNER RECORDATION CERTIFICATE
Filing Requirement of Act 74, Mich. P.A. 1970
KENT COUNTY REMONUMENTATION

For corners in

Kent (County)	SECTION	Located in:	Grattan Township	Corner Code #
1. Public Land Survey	T <u>8N</u>	R <u>9W</u>		<u>M-13</u>
	T _____	R _____		_____
	T _____	R _____		_____
	T _____	R _____		_____
2. Property Controlling in Section	S _____	T _____	R _____	_____
	S _____	T _____	R _____	_____
3. Miscellaneous Property in Sec.	S _____	T _____	R _____	_____
	S _____	T _____	R _____	_____

REG. OF DEEDS

Lucy Spauld

38 DEC 14 AM 8:00

STATE OF MICHIGAN
 COUNTY OF KENT
 RECEIVED FOR RECORD

11013

Register of Deeds Stamp & File Number

4. Lot No. _____, Recorded Plat _____
 5. Private Claims _____

I, Randy Kolehouse, in a field survey on January 9 19 98, do hereby certify that under requirements of P.A. 74 Michigan P.A. of 1970, the corner points mentioned in lines 1 and 2 above were in conformance with regulations and rules therefore as required in the current manual of survey instructions of the United States Department of the Interior, Bureau of Land Management or by a decree of a Court of Law and/or that the corner points mentioned in lines 3, 4 and 5 above were in conformance with the rules of the Michigan Board of Land Surveyors or by a Decree of a Court of Law; established, re-established, monumented, re-monumented, recovered, found as expressed below:

NOTE: Not more than 4 corners, all in the same town and range, may be recorded on this certificate.

A. Description of original monument and accessories and/or subsequent restoration:

M-13	1837	G.L.O. Notes	N. Brookfield	Set Post
	1932	Witness Map	K.C. Surveyor	1" Iron
	1978	L.C.R.C. #1133	Medema, Van Kooten & Assoc.	"T" Iron
	1981	L.C.R.C. #1682	Williams & Works	Fnd. "T" Iron & Stone / Set K.C. Mon.
	1991	L.C.R.C. #5915	William Byl	K.C. Monument

Note: This corner is common with M-1, T7N, R9W; A-13, T8N, R8W; A-1, T7N, R8W

This corner was originally approved by the Kent County Remonumentation Peer Group and monumented by Williams & Works on 4/14/98 and was recorded per L.C.R.C. #1682.

B. Description of corner evidence found and/or method applied in restoring or reestablishing corner:

M-13 Found a Standard Kent County Monument 12' ± North of the C/L intersection of 4 Mile Road (gravel) running East and West and Montcalm Road (gravel) running North, on line of a tree row and fence line running South, per L.C.R.C.'s #1682 and #5915 as set by Williams & Works in place of a bent "T" iron and pointed stone they found in a ring of smaller stones which checked L.C.R.C. #1133 and the K.C. Surveyor's records.

L.C.R.C. #1682

L.C.R.C. #5915

- K.C. Remon. tag and nail in SE side 40' Oak N.50°E. 39.21'
- K.C. Remon. tag and nail in S side 32' Hickory N.85°E. 53.26'
- K.C. Remon. tag and nail in NE side 28' Walnut N.55°W. 51.46'
- K.C. Remon. tag and nail in SE side 10' Ash S.40°W. 50.27'
- K.C. Remon. tag and nail in W side 8" Maple S.15°W. 49.85'

- KC Remon. tag & nail SE side 42" Oak N50°E 39.19' (m. 39.20')
- KC Remon. tag & nail S. side 36" Hickory N85°E 53.26' (m. 53.28')
- KC Remon. tag & nail NE side 28" Walnut N55°W 51.39' (m. 51.42')
- KC Remon. tag & nail SE side 12" Ash S40°W 50.25' (m. 50.29')
- K.C. Remon. tag & nail W. side 10" Maple S15°W 49.84' (m. 49.83')
- Steel bar & cap (#21272)

The selected location is accepted by me and is generally accepted by professional surveyors as the best available evidence of the position of the original corner.

C. Description of monument for corner and accessories established to perpetuate locating the position of the corner:

M-13 Standard Kent County Monument


- Nail & K.C. remon. tag on SE side 42" Oak N 50° E 39.20'
- Nail & K.C. remon. tag on S side 36" Hickory N 85° E 53.28'
- Nail & K.C. remon. tag on NE side 28" Walnut N 55° W 51.42'
- Nail & K.C. remon. tag on SE side 12" Ash S 40° W 50.29'
- Nail & K.C. remon. tag on W side 10" Maple S 15° W 49.83'

- Steel bar & cap (#21272) S 00° W 33.00'
- On C/L gravel road running N
- C/L gravel road running E-W, South 12' ±
- On tree row and fence line running S

Signed by *Randy J. Kolehouse* Date 9-30-98

EARTHTECH

Surveyor's Michigan License No. 25854

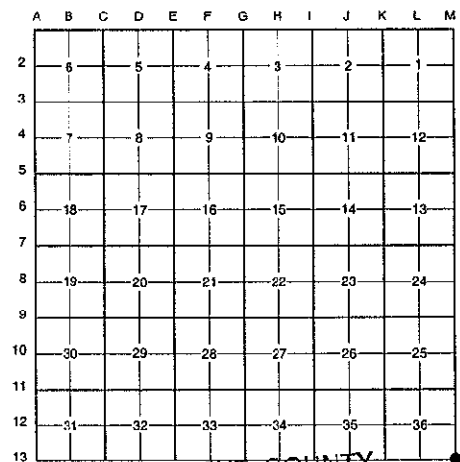

P.A. 345 1990 KENT COUNTY
 PEER APPROVED 9/24/98
 CHAIRMAN *Henry Thibodeau*