

MAR 08 1999

\$7.00
\$2.00

SECTION

LAND CORNER RECORDATION CERTIFICATE
Filing Requirement of Act 74, Mich. P.A. 1970
KENT COUNTY REMONUMENTATION

STATE OF MICHIGAN
COUNTY OF KENT
RECEIVED FOR RECORD
38 DEC 14 AM 8:00
REG. OF DEEDS
Lucy Bond


For corners in

Kent (County)	Located in:	Grattan Township	Corner Code #
1. Public Land Survey	T <u>8N</u>	R <u>9W</u>	<u>B-1</u>
	T _____	R _____	_____
	T _____	R _____	_____
	T _____	R _____	_____
2. Property Controlling in Section	S _____	T _____	R _____
	S _____	T _____	R _____
3. Miscellaneous Property in Sec.	S _____	T _____	R _____
	S _____	T _____	R _____

10962

Register of Deeds Stamp & File Number

- 4. Lot No. _____, Recorded Plat _____
- 5. Private Claims _____

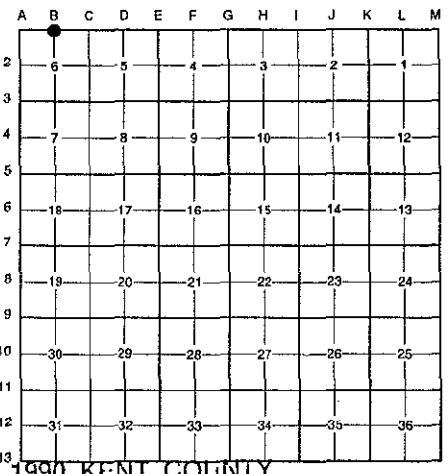

I, Randy Kolehouse, in a field survey on February 5 19 98, do hereby certify that under requirements of P.A. 74 Michigan P.A. of 1970, the corner points mentioned in lines 1 and 2 above were in conformance with regulations and rules therefore as required in the current manual of survey instructions of the United States Department of the interior, Bureau of Land Management or by a decree of a Court of Law and/or that the corner points mentioned in lines 3, 4 and 5 above were in conformance with the rules of the Michigan Board of Land Surveyors or by a Decree of a Court of Law; established, re-established, monumented, re-monumented, recovered, found as expressed below:

NOTE: Not more than 4 corners, all in the same town and range, may be recorded on this certificate.

A. Description of original monument and accessories and/or subsequent restoration:

B-1 This corner was not originally set by the G.L.O.

N/A	Witness Map	K.C. Surveyor	3/4" Iron
1978	L.C.R.C. #1122	Williams & Works	3/4" Iron
1978	L.C.R.C. #1205	Nederveid & Jonker	3/4" Round Iron (B-13, T9N, R9W)
1980	L.C.R.C. #1731	Williams & Works	Fnd. 3/4" Iron Pipe / Set K.C. Monument (B-13, T9N, R9W)
1989	L.C.R.C. #5175	John Bueche	K.C. Monument (B-13, T9N, R9W)
1997	L.C.R.C. #9636	Kirk Breitels	K.C. Monument (B-13, T9N, R9W)

P.A. 345¹³ 1990 KENT COUNTY
PEER APPROVED 6/25/98
CHAIRMAN [Signature]

Note: This corner is common with B-13, T9N, R9W.

This corner was originally approved by the Kent County Remonumentation Peer Group and monumented by Williams & Works 12/23/80 and was recorded per L.C.R.C. 1731.

B. Description of corner evidence found and/or method applied in restoring or reestablishing corner:

B-1 Found a Standard Kent County Monument 6' South of the C/L of 10 Mile Road (bit.) running East and West and 5' East of the C/L of Greenland Drive (gravel) running North per L.C.R.C.'s #1731, #5175, and #9636 as set by Williams & Works in place of a 3/4" iron pipe they found which checked L.C.R.C.'s #1205 and #1122.

L.C.R.C. #1731	L.C.R.C. #9636
K.C. Remon. Tag & Nail in N. Side P. Pole S 65° E 81.41'	Nail & KC Remon. tag N side P. Pole S 65° E 81.41' (m. 81.46')
K.C. Remon. Tag & Nail in NW Side P. Pole S 75° W 92.29'	Nail & KC Remon. tag NW side P. Pole S 75° W 92.29' (m. 92.30')
NW Cor. Hse. Fnd. S 50° E 106.14'	NW corner house foundation S 50° E 106.14' (m. 106.20')
NE Cor. Hse. Fnd. S 05° W 102.26'	NE corner house foundation S 05° W 102.12'

The selected location is accepted by me and is generally accepted by professional surveyors as the best available evidence of the position of the original corner.

C. Description of monument for corner and accessories established to perpetuate locating the position of the corner:

B-1 Standard Kent County Monument

Nail & K.C. remon. tag on N side P. pole S 65° E 81.46'	NE cor. hse. fndn. S 05° W 102.12'
Nail & K.C. remon. tag on NW side P. pole S 75° W 92.30'	C/L of bit. road running E-W, North 6.0'
Nail & K.C. remon. tag on SW side guard post N 40° W 47.64'	C/L of gravel road running N, West 5.0'
Nail & K.C. remon. tag on E side 8" Oak N 05° W 95.66'	
NW cor. fndn. S 50° E 106.20'	
NW cor. brick garage S 30° W 109.33'	

Signed by [Signature] Date 11/18/98

EARTH TECH

Surveyor's Michigan License No. 25854

