

SURVEY & REMONUMENTATION

MAR 08 1999

LAND CORNER RECORDATION CERTIFICATE
Filing Requirement of Act 74, Mich. P.A. 1970
KENT COUNTY REMONUMENTATION

STATE OF MICHIGAN
 COUNTY OF KENT
 RECEIVED FOR RECORD
 30 OCT 23 AM 9:58
 REG. OF DEEDS
Tom Starr

For corners in

SECTION


| Kent (County) | Located in: Grattan Township | Corner Code # |
|---------------------------------------|---------------------------------|-------------------------|
| 1. Public Land Survey | T <u>8N</u> R <u>9W</u> | <u>D-5S</u> |
| | T _____ R _____ | _____ |
| | T _____ R _____ | <u>Witness Monument</u> |
| | T _____ R _____ | _____ |
| 2. Property Controlling in Section | S _____ T _____ R _____ | _____ |
| | S _____ T _____ R _____ | _____ |
| 3. Miscellaneous Property in Sec. | S _____ T _____ R _____ | _____ |
| | S _____ T _____ R _____ | _____ |

other code #2
Seq #2

10845

Register of Deeds Stamp & File Number

4. Lot No. _____, Recorded Plat _____
 5. Private Claims _____

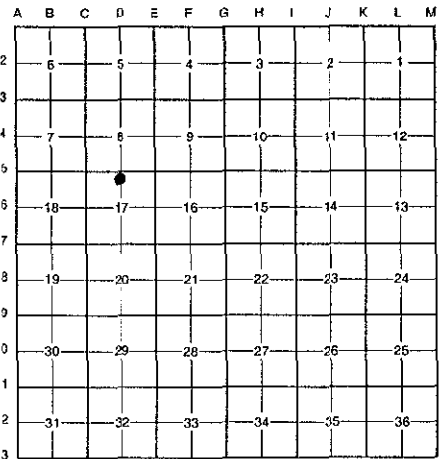

I, Randy Kolehouse, in a field survey on March 24 19 98, do hereby certify that under requirements of P.A. 74 Michigan P.A. of 1970, the corner points mentioned in lines 1 and 2 above were in conformance with regulations and rules therefore as required in the current manual of survey instructions of the United States Department of the interior, Bureau of Land Management or by a decree of a Court of Law and/or that the corner points mentioned in lines 3, 4 and 5 above were in conformance with the rules of the Michigan Board of Land Surveyors or by a Decree of a Court of Law; established, re-established, monumented, re-monumented, recovered, found as expressed below:

NOTE: Not more than 4 corners, all in the same town and range, may be recorded on this certificate.

A. Description of original monument and accessories and/or subsequent restoration:

D-5 This corner was not originally set by the G.L.O.

| | | | |
|------|-------------------------|--------------------|---------------------------------------|
| 1972 | Cert. Survey L. 1 P. 50 | Moore & Bruggink | Iron |
| 1993 | L.C.R.C. #6775 | T. Starr | Fnd. Iron / Set K.C. Witness Monument |
| 1994 | L.C.R.C. #8002 | Glaza & Associates | K.C. Witness Monument |

This corner was originally approved by the Kent County Remonumentation Peer Group and monumented by Thomas Starr on 3/15/93 and was recorded per L.C.R.C. #6775.

B. Description of corner evidence found and/or method applied in restoring or reestablishing corner:

D-5 Found a Standard Kent County Witness Monument 200' ± South of South edge of Toohey Lake, on line of a tree row running South, per L.C.R.C.'s #6775 and #8002 as set by Tom Starr in place of a iron he found which checked a 1972 survey by Moore & Bruggink.

L.C.R.C. #6775

L.C.R.C. #8002

Nail & Tag in W. side 6" Maple S 20° E 37.31'
 Nail & Tag in S. side 18" Oak S 80° E 19.71'
 Nail & Tag in W. side 6" Maple N 35° E 19.57'
 Nail & Tag in W. side 8" Beech N 05° W 27.52'
 Nail & Tag in W. side 30" Beech N 50° W 20.78'
 Nail & Tag in N. side 6" Maple S 80° W 43.30'

Nail & K.C. remon tag in W side 8" Maple S 20° E 37.31' (m. 37.30')
 Nail & K.C. remon tag in N side 18" Oak S 80° E 19.71' (m. 19.73')
 Nail & K.C. remon tag in W side 10" Maple N 35° E 19.65'
 Nail & K.C. remon tag in W side 12" Beech N 05° W 27.54' (m. 27.69')
 Nail & K.C. remon tag in W side 30" Beech N 50° W 20.90' (m. 20.90')
 Nail & K.C. remon tag in N side 8" Maple S 80° W 43.31' (m. 43.40')

The selected location is accepted by me and is generally accepted by professional surveyors as the best available evidence of the position of the original corner.

C. Description of monument for corner and accessories established to perpetuate locating the position of the corner:

D-5 Standard Kent County Witness Monument

Nail & K.C. remon. tag on W side 8" maple S 20° E 37.30'
 Nail & K.C. remon. tag on N side 18" Oak S 80° E 19.73'
 Nail & K.C. remon. tag on W side 10" Maple N 35° E 19.65'
 Nail & K.C. remon. tag on W side 12" Beech N 05° W 27.69'
 Nail & K.C. remon. tag on W side 30" Beech N 50° W 20.90'
 Nail & K.C. remon. tag on N side 8" Maple S 80° W 43.40'

On tree row running S
 South edge of Toohey Lake, North 200' ±

P.A. 345 1990 KENT COUNTY

PEER APPROVED 6/25/98

CHAIRMAN *Tom Starr*

Signed by *Randy J. Kolehouse*
 EARTH TECH

Date 9-1-98

Surveyor's Michigan License No. 25854

