

SURVEY & REMONUMENTATION

\$7.00
\$2.00

DEC 0 8 1999

LAND CORNER RECORDATION CERTIFICATE
Filing Requirement of Act 74, Mich. P.A. 1970
KENT COUNTY REMONUMENTATION

SECTION

For corners in


Kent (County)	Located in:	Grattan Township	Corner Code #
1. Public Land Survey	T <u>8N</u>	R <u>9W</u>	<u>D-5W</u>
	T _____	R _____	_____
	T _____	R _____	<u>Witness Monument</u>
	T _____	R _____	_____
2. Property Controlling in Section	S _____	T _____	R _____
	S _____	T _____	R _____
3. Miscellaneous Property in Sec.	S _____	T _____	R _____
	S _____	T _____	R _____

STATE OF MICHIGAN
COUNTY OF KENT
RECEIVED FOR RECORDATION
90 OCT 23 AM 9:50
REG. OF DEEDS
Other code # 3
Seq # 2
10842
Register of Deeds Stamp & File Number

4. Lot No. _____, Recorded Plat _____
5. Private Claims _____

I, Randy Kolehouse, in a field survey on March 24 19 98, do hereby certify that under requirements of P.A. 74 Michigan P.A. of 1970, the corner points mentioned in lines 1 and 2 above were in conformance with regulations and rules therefore as required in the current manual of survey instructions of the United States Department of the interior, Bureau of Land Management or by a decree of a Court of Law and/or that the corner points mentioned in lines 3, 4 and 5 above were in conformance with the rules of the Michigan Board of Land Surveyors or by a Decree of a Court of Law; established, re-established, monumented, re-monumented, recovered, found as expressed below:

NOTE: Not more than 4 corners, all in the same town and range, may be recorded on this certificate.

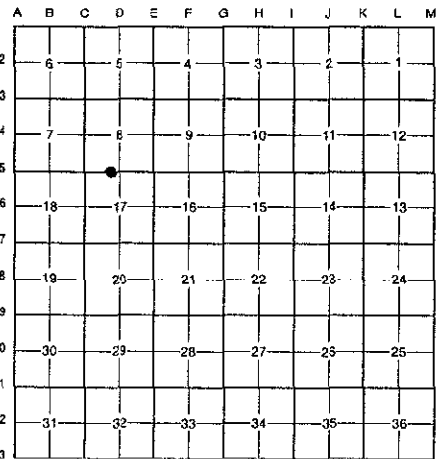

A. Description of original monument and accessories and/or subsequent restoration:

D-5	This corner was not originally set by the G.L.O.		
1972	Cert. Survey L. 1 P. 50	Moore & Bruggink	Iron
1993	L.C.R.C. #6776	T. Starr	Fnd. Iron / Set K.C. Witness Monument
1994	L.C.R.C. #8001	Glaza & Associates	K.C. Witness Monument

P.A. 345 1990 KENT COUNTY
PEER APPROVED 6/25/98
CHAIRMAN Harry Tucker

This corner was originally approved by the Kent County Remonumentation Peer Group and monumented by Tom Starr on 3/15/93 and was recorded per L.C.R.C. #6776.

B. Description of corner evidence found and/or method applied in restoring or reestablishing corner:

D-5 Found a Standard Kent County Witness Monument on the West side of Toohy Lake on line of a tree row running East and West and 1.0' South of a fence line running East and West per L.C.R.C.'s #6776 and #8001 as set by Tom Starr in place of an iron he found which checked a 1972 survey by Moore & Bruggink.

L.C.R.C. #6676

L.C.R.C. #8001

- Nail & Tag in S. side 30" Oak N 72° W 9.66'
- Nail & Tag in W. side 10" Oak N 32° W 3.35'
- Nail & Tag in E. side 12" Maple N 54° E 3.45'
- Nail & Tag in N. side 10" Maple S 88° E 10.85'
- Nail & Tag in E. side 12" Triple Maple S 40° E 29.65'
- Nail & Tag in E. side 10" Quad. Beech S 05° E 4.83'

- Nail & K.C. remon tag in S side 30" Oak N 72° W 9.62' (m. 9.61')
- Nail & K.C. remon tag in W side 10" Oak N 32° W 3.28' (m. 3.29')
- Nail & K.C. remon tag in E side 12" Maple (stump) N 54° E 3.41' (m. 3.42')
- Nail & K.C. remon tag in N side 12" Maple S 88° E 11.01' (m. 11.07')
- Nail & K.C. remon tag in E side 10" Triple Maple S 40° E 29.70' (m. 29.68')
- Nail & K.C. remon tag in E side 14" Quad. Beech S 05° E 4.87' (m. 4.88')

The selected location is accepted by me and is generally accepted by professional surveyors as the best available evidence of the position of the original corner.

C. Description of monument for corner and accessories established to perpetuate locating the position of the corner:

D-5 Standard Kent County Witness Monument

- Nail & K.C. remon. tag on S side 30" Oak N 72° W 9.61'
- Nail & K.C. remon. tag on W side 10" Oak N 32° W 3.29'
- Nail & K.C. remon. tag on E side 12" Oak (stump) N 54° E 3.42'
- Nail & K.C. remon. tag on N side 12" Maple S 88° E 11.07'
- Nail & K.C. remon. tag on E side 10" Triple Maple S 40° E 29.68'
- Nail & K.C. remon. tag on E side 4" Quad. Beech S 05° E 4.88'

On tree row running E-W
Fence line running E-W, North 1.0'

Signed by Randy Kolehouse
EARTH TECH

Date 9-1-98

Surveyor's Michigan License No. 25854

