

SEP 08 1993

LAND CORNER RECORDATION CERTIFICATE  
Filing Requirement of Act 74, Mich. P.A. 1970  
KENT COUNTY REMONUMENTATION

Other code # 5  
Seq # 2

STATE OF MICHIGAN  
COUNTY OF KENT  
RECEIVED FOR RECORD  
38 OCT 23 AM 9:58  
REG. OF DEEDS  
*Eric J. Starr*

For corners in SECTION


Kent (County)	Located in:	Grattan Township	Corner Code #
1. Public Land Survey	T <u>8N</u>	R <u>9W</u>	<u>E-3W</u>
	T _____	R _____	_____
	T _____	R _____	<u>Witness Monument</u>
	T _____	R _____	_____
2. Property Controlling in Section	S _____	T _____	R _____
	S _____	T _____	R _____
3. Miscellaneous Property in Sec.	S _____	T _____	R _____
	S _____	T _____	R _____

10850

Register of Deeds Stamp & File Number

4. Lot No. \_\_\_\_\_, Recorded Plat \_\_\_\_\_

5. Private Claims \_\_\_\_\_

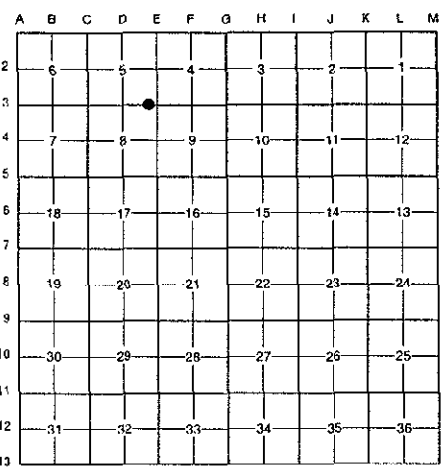

I, Randy Kolehouse, in a field survey on March 24 19 98, do hereby certify that under requirements of P.A. 74 Michigan P.A. of 1970, the corner points mentioned in lines 1 and 2 above were in conformance with regulations and rules therefore as required in the current manual of survey instructions of the United States Department of the interior, Bureau of Land Management or by a decree of a Court of Law and/or that the corner points mentioned in lines 3, 4 and 5 above were in conformance with the rules of the Michigan Board of Land Surveyors or by a Decree of a Court of Law; established, re-established, monumented, re-monumented, recovered, found as expressed below:

**NOTE:** Not more than 4 corners, all in the same town and range, may be recorded on this certificate.

A. Description of original monument and accessories and/or subsequent restoration:

E-3	1837	G.L.O. Notes	Cathcart	Meander Corner
	1993	L.C.R.C. #6779	Thomas Starr	Set K.C. Witness Monument
	1995	L.C.R.C. #8013	Glaza & Associates	K.C. Witness Monument

This corner was originally approved by the Kent County Remonumentation Peer Group and monumented by Thomas Starr on 3/15/98 and was recorded per L.C.R.C. #6779.

B. Description of corner evidence found and/or method applied in restoring or reestablishing corner:

E-3 Found a Standard Kent County Witness Monument on the West side of Muskrat Lake 1' North of a fence line running East and West and 1600' East of the South 1/4 corner of Section 5 per L.C.R.C.'s #6779 and #8013 as set by Thomas Starr 1600' East of the South 1/4 corner of Section 5.

L.C.R.C. #6779	L.C.R.C. #8013
Nail & Tag in S. side of Power Pole S 90° W 3.51'	Nail & K.C. remon tag in S. side power pole S 90° W 3.51' (m. 3.53')
Nail & Tag in E. side of 20" Maple S 35° E 3.12'	Nail & K.C. remon tag in E side 24" Maple S 35° E 3.15' (m. 3.16')
Nail & Tag in N. side of 16" Oak S 55° E 9.67'	Nail & K.C. remon tag in N side 16" Oak S 55° E 9.71' (m. 9.72')
N.E. Corner Building S 40° W 3.53'	NE corner building S 40° W 3.60' (m. 3.49')
N.E. Corner Building S 60° E 21.49'	NE corner building S 60° E 21.59' (m. 21.60')
East and West fence line - South 1'	East & West fence line is South 1'


The selected location is accepted by me and is generally accepted by professional surveyors as the best available evidence of the position of the original corner.

C. Description of monument for corner and accessories established to perpetuate locating the position of the corner:

E-3 Standard Kent County Witness Monument

- Nail & K.C. remon. tag on S side P. pole S 90° W 3.53'
- Nail & K.C. remon. tag on E side 24" Maple S 35° E 3.16'
- Nail & K.C. remon. tag on N side 16" Oak S 55° E 9.72'
- NE corner building S 40° W 3.49'
- NE corner building S 60° E 21.60'
- Fence line running E-W, South 1'

P.A. 345 1990 KENT COUNTY  
PEER APPROVED 6/25/98  
CHAIRMAN [Signature]

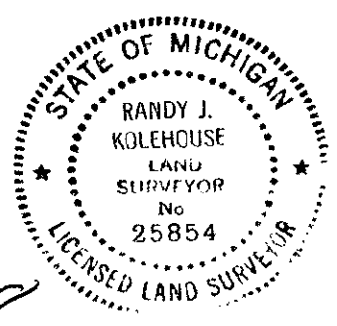

Signed by [Signature] Date 9-1-98  
EARTH TECH

Surveyor's Michigan License No. 25854