

SURVEYOR'S
REMONUMENTATION

\$7.00
\$2.00

MAR 06 1993

other code #6
Seq # 2

SECTION LAND CORNER RECORDATION CERTIFICATE
Filing Requirement of Act 74, Mich. P.A. 1970
KENT COUNTY REMONUMENTATION

For corners in

Kent (County)	Located in: Grattan Township	Corner Code #
1. Public Land Survey	T <u>8N</u> R <u>9W</u>	<u>D-5N</u>
	T _____ R _____	_____
	T _____ R _____	<u>Witness Monument</u>
	T _____ R _____	_____
2. Property Controlling in Section	S _____ T _____ R _____	_____
	S _____ T _____ R _____	_____
3. Miscellaneous Property in Sec.	S _____ T _____ R _____	_____
	S _____ T _____ R _____	_____
4. Lot No. _____, Recorded Plat _____		
5. Private Claims _____		


STATE OF MICHIGAN
COUNTY OF KENT
RECEIVED FOR RECORD

98 OCT 23 AM 9:58

REG. OF DEEDS
Lucy J. Sand

10843
Register of Deeds Stamp & File Number

I, Randy Kolehouse, in a field survey on March 30 19 98, do hereby certify that under requirements of P.A. 74 Michigan P.A. of 1970, the corner points mentioned in lines 1 and 2 above were in conformance with regulations and rules therefore as required in the current manual of survey instructions of the United States Department of the interior, Bureau of Land Management or by a decree of a Court of Law and/or that the corner points mentioned in lines 3, 4 and 5 above were in conformance with the rules of the Michigan Board of Land Surveyors or by a Decree of a Court of Law; established, re-established, monumented, re-monumented, recovered, found as expressed below:

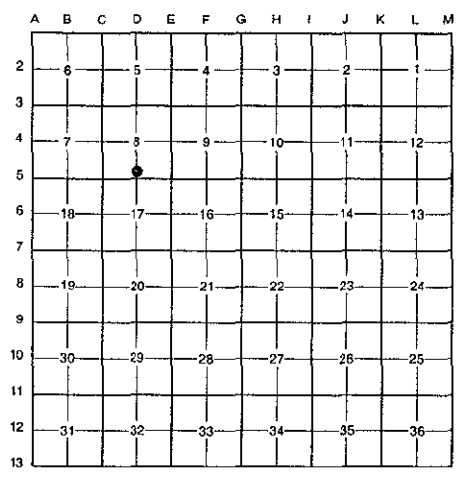

NOTE: Not more than 4 corners, all in the same town and range, may be recorded on this certificate.

A. Description of original monument and accessories and/or subsequent restoration:

D-5 This corner was not originally set by the G.L.O.

Date	Cert. Survey	Surveyor	Monument
1972	Cert. Survey L. 1 P. 50	Moore & Bruggink	Iron
1993	L.C.R.C. #6773	T. Starr	Fnd. Iron / Set K.C. Witness Monument
1994	L.C.R.C. #8003	Glaza & Associates	K.C. Witness Monument

This corner was originally approved by the Kent County Remonumentation Peer Group and monumented by Thomas Starr on 3/15/93 and was recorded per L.C.R.C. #6773.

B. Description of corner evidence found and/or method applied in restoring or reestablishing corner:

D-5 Found a Standard Kent County Witness Monument on the North side of Toohey Lake 2.5' West of an old fence line running North and South and 150' ± North of the North edge of Toohey Lake per L.C.R.C.'s #6773 and #8003 as set by Tom Starr in place of a iron he found which checked a 1972 survey by Moore & Bruggink.


L.C.R.C. #6773	L.C.R.C. #8003
Nail & Tag in S. side 8" Ash S 85° W 73.45'	Nail & K.C. remon tag in S side 8" Elm S 85° W 73.45' (m. 73.40')
Nail & Tag in E. side Twin 28" Willow N 30° W 62.43'	Nail & K.C. remon tag in E side 28" Twin Willow N 30° W 62.43' (m. 62.42')
Nail & Tag in W. side 8" Oak N 30° E 52.95'	Nail & K.C. remon tag in W side 12" Oak N 30° E 52.86' (m. 52.90')
Nail & Tag in W. side 14" Apple N 55° E 58.25'	Nail & K.C. remon tag in W side 14" Apple N 55° E 58.15' (m. 58.17')
Nail & Tag in W. side Triple 4" Willow S 25° E 63.72'	Nail & K.C. remon tag in W side 6" Triple Willow S 25° E 63.77' (m. 63.75')

The selected location is accepted by me and is generally accepted by professional surveyors as the best available evidence of the position of the original corner.

C. Description of monument for corner and accessories established to perpetuate locating the position of the corner:

- D-5 Standard Kent County Witness Monument
- Nail & K.C. remon. tag on S side 8" Elm S 85° W 73.40'
 - Nail & K.C. remon. tag on E side 30" Twin Willow N 30° W 62.42'
 - Nail & K.C. remon. tag on W side 12" Oak N 30° E 52.90'
 - Nail & K.C. remon. tag on W side 14" Apple N 55° E 58.17'
 - Nail & K.C. remon. tag on W side 6" Triple Willow S 25° E 63.75'
 - Fence line running N-S, East 2.5'
 - North edge of Toohey Lake, South 150' ±

P.A. 345 1990 KENT COUNTY
PEER APPROVED 6/25/98
CHAIRMAN Randy Kolehouse

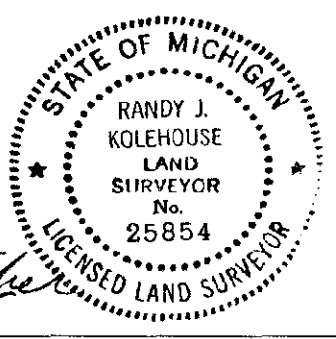

Signed by Randy J. Kolehouse
EARTH TECH

Date 7-1-98

Surveyor's Michigan License No. 25854