

**SURVEY & REMONUMENTATION**

FEB 14 1997

KENT COUNTY REMONUMENTATION

**COMMISSION LAND CORNER RECORDATION CERTIFICATE**  
Filing Requirement of Act 74, Mich. P.A. 1970

For corners in

KENT COUNTY  
(County)

Located In:  
T

Corner Code #

1. Public Land Survey		<u>F 8N R 11W</u>	<u>M-2</u>
		<u>T 8N R 10W</u>	<u>A-2</u>
		T R	
		T R	
2. Property Controlling in Section	S	T R	
	S	T R	
3. Miscellaneous Property in Sec.	S	T R	
	S	T R	

4. Lot No. \_\_\_\_\_, Recorded Plat \_\_\_\_\_  
5. Private Claims \_\_\_\_\_

I, Kirk Breitels, in a field survey on Jan. 22, 1996 do hereby state that under requirements of P.A. 74, Michigan P.A. of 1970, the corner points mentioned in lines 1 and 2 above were in conformance with regulations and rules therefore as required in the current manual of survey instructions of the United States Department of the Interior, Bureau of Land Management or by a decree of a Court of Law and /or that the corner points mentioned in lines 3, 4 and 5 above were in conformance with the rules of the Michigan Board of Land Surveyors or by a Decree of a Court of Law; established, re-established, monumented, recovered, found as expressed below:

NOTE: Not more than 2 corners, all in the same town and range, may be recorded on this certificate.

STATE OF MICHIGAN  
COUNTY OF KENT  
RECEIVED FOR RECORD  
96 MAR 20 AM 8:59  
REG. OF DEEDS  
*Luis S. Bond*  
**9119**  
Register of Deeds Stamp & File Number

A	B	C	D	E	F	G	H	I	J	K	L	M
1												
2	6	5	4	3	2	1						
3												
4	7	8	9	10	11	12						
5												
6	18	17	16	15	14	13						
7												
8	19	20	21	22	23	24						
9												
10	30	29	28	27	26	25						
11												
12	31	32	33	34	35	36						
13												

A. Description of original monument and accessories and/or subsequent restoration:

M-2	1837	GLO	Brookfield	Set Post
		Kent Co. Wit.		Iron
	1973	LCRC #571	Spicer	Capped "T" Iron
	1981	LCRC #1975	Jonker	Set Kent County Monument
	1988	LCRC #4882	Bueche	Kent County Monument

P.A. 345 1990 KENT COUNTY  
PEER APPROVED 3/17/96  
CHAIRMAN Harry Huber

The position of this corner was previously approved by the Kent County Remonumentation Peer Group, monumented by Robert J. Jonker on 8/20/81 and was recorded per LCRC #1975.

B. Description of corner evidence found and/or method applied in restoring or reestablishing corner:

M-2 Found standard Kent Co. Mon. (Harrison) per witnesses from above LCRC as set by Robert J. Jonker in place of the "T" Iron he found. Said "T" Iron checks with Kent Co. Wit. and LCRC #571.

LCRC #1975 & #4882

Nail & KC Remon. tag SW side 20" Oak	S52°E	6.74'
Nail & KC Remon. tag SE side 10" Oak	N36°E	7.71'
Nail & KC Remon. tag N. side 16" Oak	S89°E	24.97'
Nail & KC Remon. tag SE side 4" Oak	S48°W	25.55'
Nail & KC Remon. tag NE side 5" Oak	N68°W	26.58'


The selected location is accepted by me and is generally accepted by professional surveyors as the best available evidence of the position of the original corner.

C. Description of monument for corner and accessories established to perpetuate locating the position of the corner:

M-2 Standard Kent County Monument

New Nail & KC Remon. tag SW side 27" Oak	S52°E	6.69'
New Nail & KC Remon. tag SE side 12" Oak	N36°E	7.69'
New Nail & KC Remon. tag N. side 20" Oak	S89°E	25.01'
New Nail & KC Remon. tag SE side 8" Oak	S48°W	25.61'
New Nail & KC Remon. tag NE side 8" Oak	N68°W	26.58'

Monument is 1.5' West of Hwy. R/W fence  
Power Lines are North 400'±

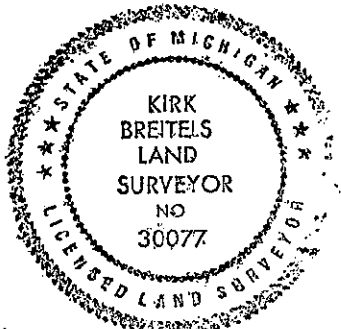

Signed by *Kirk Breitels*  
Surveyor's Michigan License No. 30077

Date 2/6/96