

FEB 14 1997

KENT COUNTY REMONUMENTATION

COMMISSION

LAND CORNER RECORDATION CERTIFICATE
Filing Requirement of Act 74, Mich. P.A. 1970

For corners in

KENT COUNTY

(County)

Located In:

§

Corner Code #

1. Public Land Survey

T 8N R 11W M-7

T 8N R 10W A-7

T R

T R

2. Property Controlling in Section

S T R

S T R

3. Miscellaneous Property in Sec.

S T R

S T R

STATE OF MICHIGAN
COUNTY OF KENT
RECEIVED FOR RECORD
96 MAR 20 AM 8:59
REG. OF DEEDS
Lucy Bond

9124

Register of Deeds Stamp & File Number

4. Lot No. _____, Recorded Plat _____

5. Private Claims _____

I, Kirk Breitels, in a field survey on Jan. 22, 1996 do hereby state that under requirements of P.A. 74, Michigan P.A. of 1970, the corner points mentioned in lines 1 and 2 above were in conformance with regulations and rules therefore as required in the current manual of survey instructions of the United States Department of the Interior, Bureau of Land Management or by a decree of a Court of Law and/or that the corner points mentioned in lines 3, 4 and 5 above were in conformance with the rules of the Michigan Board of Land Surveyors or by a Decree of a Court of Law, established, re-established, monumented, recovered, found as expressed below:

NOTE: Not more than 2 corners, all in the same town and range, may be recorded on this certificate.

A	B	C	D	E	F	G	H	I	J	K	L	M
1												
2	6		5		4		3		2		1	
3												
4	7		8		9		10		11		12	
5												
6	18		17		16		15		14		13	
7												
8	19		20		21		22		23		24	
9												
10	30		29		28		27		26		25	
11												
12	31		32		33		34		35		36	
13												

A. Description of original monument and accessories and/or subsequent restoration:

M-7	1837	GLO	Brookfield	Set Post
		Kent Co. Wit.		"T" Iron on Mon.
	1973	LCRC #459	Spicer	"T" Iron
	1981	LCRC #1978	Jonker	Set Kent County Monument in Mon. Box
	1988	LCRC #4887	Bueche	Kent County Monument in Mon. Box

P.A. 345 1990 KENT COUNTY

PEER APPROVED 3/21/96
CHAIRMAN *Harry Huber*

The position of this corner was previously approved by the Kent County Remonumentation Peer Group, monumented by Robert J. Jonker on 8/20/81 and was recorded per LCRC #1978.

B. Description of corner evidence found and/or method applied in restoring or reestablishing corner:

M-7 Found standard Kent Co. Mon. (Harrison) per witnesses from above LCRC as set by Robert J. Jonker in place of the "T" Iron he found inside a Mon. Box. Said "T" Iron checks with Kent Co. Wit. and LCRC #459.

LCRC #1978 & #4887

Nail & KC Remon. tag N. side T. Pole	S75°W	65.87'
Nail & KC Remon. tag SW side 30" Tw. Chestnut	N28°W	68.83'
Nail & KC Remon. tag W. side T. Pole	N20°E	75.0'
NW cor. garage foundation	S25°E	96.71'
Face of steel fence post	S07°W	25.52'


The selected location is accepted by me and is generally accepted by professional surveyors as the best available evidence of the position of the original corner.

C. Description of monument for corner and accessories established to perpetuate locating the position of the corner:

M-7 Standard Kent County Monument

Nail & KC Remon. tag N. side T. Pole	S75°W	65.93'
New Nail & KC Remon. tag SW side 32" Tw. Chestnut	N28°W	68.66'
Nail & KC Remon. tag W. side T. Pole	N20°E	75.00'
NW cor. garage foundation	S25°E	96.76'
Face of steel fence post	S07°W	25.52'

On C/L bit. E-W & N

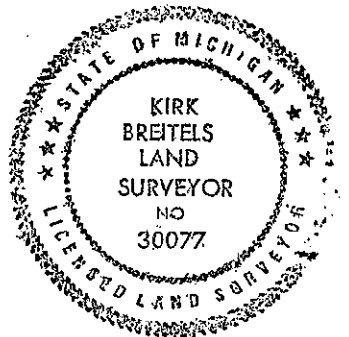

Signed by *Kirk Breitels*
Surveyor's Michigan License No. 30077

Date 2/6/96