

**SURVEY & REMONUMENTATION**

FEB 14 1997

KENT COUNTY REMONUMENTATION

COMMISSION

LAND CORNER RECORDATION CERTIFICATE  
Filing Requirement of Act 74, Mich. P.A. 1970

For corners in

KENT COUNTY

(County)

Located In:

Corner Code #

1. Public Land Survey

T 8N R 11W M-9

T 8N R 10W A-9

T R

T R

2. Property Controlling in Section

S T R

S T R

3. Miscellaneous Property in Sec.

S T R

S T R

4. Lot No. \_\_\_\_\_, Recorded Plat \_\_\_\_\_

5. Private Claims \_\_\_\_\_

I, Kirk Breitels, in a field survey on Jan. 23, 1996 do hereby state that under requirements of P.A. 74, Michigan P.A. of 1970, the corner points mentioned in lines 1 and 2 above were in conformance with regulations and rules therefore as required in the current manual of survey instructions of the United States Department of the Interior, Bureau of Land Management or by a decree of a Court of Law and /or that the corner points mentioned in lines 3, 4 and 5 above were in conformance with the rules of the Michigan Board of Land Surveyors or by a Decree of a Court of Law; established, re-established, monumented, recovered, found as expressed below:

NOTE: Not more than 2 corners, all in the same town and range, may be recorded on this certificate.

P.A. 345 1990 KENT COUNTY

PEER APPROVED 3/7/96

CHAIRMAN [Signature]

STATE OF MICHIGAN  
COUNTY OF KENT  
RECEIVED FOR RECORD  
95 MAR 20 AM 9:00  
REG. OF DEEDS  
[Signature]  
9126  
Register of Deeds Stamp & File Number

1	A	B	C	D	E	F	G	H	I	J	K	L	M
2		6		5		4		3		2		1	
3													
4		7		8		9		10		11		12	
5													
6		18		17		16		15		14		13	
7													
8		19		20		21		22		23		24	
9													
10		30		29		28		27		26		25	
11													
12		31		32		33		34		35		36	
13													

A. Description of original monument and accessories and/or subsequent restoration:

M-9	1837	GLO	Brookfield	Set Post
	1972	Kent Co. Wit.		Mon. Box
	1979	LCRC #1310	Nederveld	Iron
	1981	LCRC #1980	Jonker	Set Kent County Monument in Mon. Box
	1988	LCRC #4889	Bueche	Kent County Monument in Mon. Box

The position of this corner was previously approved by the Kent County Remonumentation Peer Group, monumented by Robert J. Jonker on 8/20/81 and was recorded per LCRC #1980.

B. Description of corner evidence found and/or method applied in restoring or reestablishing corner:

M-9 Found standard Kent Co. Mon. (Harrison) per witnesses from above LCRC as set by Robert J. Jonker in place of the Iron he found inside a Mon. Box. Said Iron checks with Kent Co. Wit. and LCRC #1310.


LCRC #1980 & #4889

PK Nail & KC Remon. tag in curb joint	S43°E	48.28'
Nail & KC Remon. tag NW side P. Pole	S49°W	90.97'
Nail & KC Remon. tag SW side L. Pole	N45°W	61.80'
Nail & KC Remon. tag SW side T. Pole	S29°E	58.94'
SW cor. house foundation	N43°E	161.41'

The selected location is accepted by me and is generally accepted by professional surveyors as the best available evidence of the position of the original corner.

C. Description of monument for corner and accessories established to perpetuate locating the position of the corner:

M-9 Standard Kent County Monument in Mon. Box		
PK Nail & KC Remon. tag in curb joint	S43°E	48.28'
Nail & KC Remon. tag NW side P. Pole	S49°W	90.97'
Nail & KC Remon. tag SW side L. Pole	N45°W	61.83'
Nail & KC Remon. tag SW side T. Pole	S29°E	58.96'
SW cor. house foundation	N43°E	161.41'
On C/L "X" bit. roads		

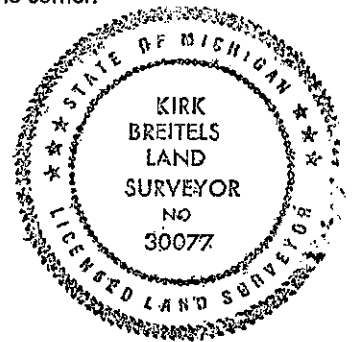

Signed by [Signature]  
Surveyor's Michigan License No. 30077

Date 2/6/96