

SURVEY & REMONUMENTATION

MAR 03 1998

**LAND CORNER RECORDATION CERTIFICATE
Filing Requirement of Act 74, Mich. P.A. 1970
KENT COUNTY REMONUMENTATION**

For corners in **SECTION**

Kent (County)	Located in: Cannon Township	Corner Code #
1. Public Land Survey	T <u>8N</u> R <u>10W</u>	<u>B-1</u>
	T _____ R _____	_____
	T _____ R _____	_____
	T _____ R _____	_____
2. Property Controlling in Section	S _____ T _____ R _____	_____
	S _____ T _____ R _____	_____
3. Miscellaneous Property in Sec.	S _____ T _____ R _____	_____
	S _____ T _____ R _____	_____

REG. OF DEEDS
 STATE OF MICHIGAN
 COUNTY OF KENT
 RECEIVED FOR RECORD
 97 OCT 15 AM 8:43
 10077
 Register of Deeds Stamp & File Number

- 4. Lot No. _____, Recorded Plat _____
- 5. Private Claims _____


I, Randy Kolehouse, in a field survey on June 10 19 97, do hereby certify that under requirements of P.A. 74 Michigan P.A. of 1970, the corner points mentioned in lines 1 and 2 above were in conformance with regulations and rules therefore as required in the current manual of survey instructions of the United States Department of the interior, Bureau of Land Management or by a decree of a Court of Law and/or that the corner points mentioned in lines 3, 4 and 5 above were in conformance with the rules of the Michigan Board of Land Surveyors or by a Decree of a Court of Law; established, re-established, monumented, re-monumented, recovered, found as expressed below:

NOTE: Not more than 4 corners, all in the same town and range, may be recorded on this certificate.

A. Description of original monument and accessories and/or subsequent restoration:

B-1	This corner was not originally set by the G.L.O.	
N/A	Witness Map	K.C. Surveyor
1954-73	Notes	Williams & Works
1973	L.C.R.C. #449	Medema, Van Kooten & Assoc.
1984	L.C.R.C. #3977	William Byl
1988	L.C.R.C. #4839	Olson, Meyers & May

P.A. 345 1990 KENT COUNTY
 PEER APPROVED 6/26/97
 CHAIRMAN Randy Kolehouse
 Fnd. 1" Iron Pipe in Mon. Box / Set K.C. Mon. in Mon. Box
 K.C. Monument in Monument Box

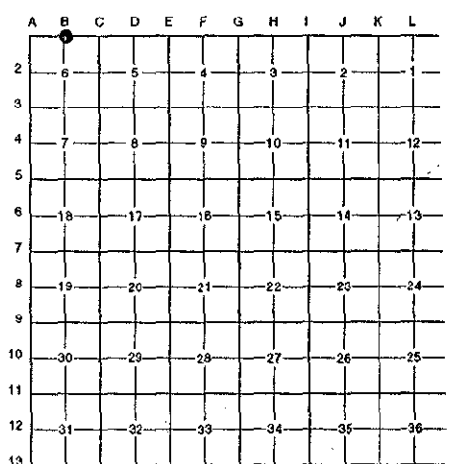

Note: This corner is not common with B-13, T9N, R10W.

This corner was originally approved by the Kent County Remonumentation Peer Group and monumented by William Byl on 10/17/84 and was recorded per L.C.R.C. #3977.

B. Description of corner evidence found and/or method applied in restoring or reestablishing corner:

B-1 Found a Standard Kent County Monument on the Township line in a monument box 2' North of the C/L of 10 Mile Road (bit.) running East and West and 185' ± East of the C/L of Courtland Road (bit.) running South per L.C.R.C.'s #3977 and #4839 as set by William Byl in place of a 1" iron pipe he found in a monument box 0.12' South of the South line of Sec. 31, T9N, R10W. Checked L.C.R.C. #449, the 1954-73 notes of Williams & Works, and the K.C. Surveyor's records.

L.C.R.C. #3977 L.C.R.C. #4839


Nail & tag, E. sd. Power pole S 60 E 59.88'
 Nail & tag, N. sd. MBT pole S 75 W 99.80'
 Nail & tag, S. sd. Power pole N 65 E 79.62'
 SW cor. of Hse. #5227 (conc. block) N 25 W 65.22'
 SE cor. of Hse. #5227 (stone) N 10 E 64.92'
 Kent Co. Monument at S 1/4 Cor. Sec. 31 N 90 W 184.82'

Nail & K.C. Remon tag E sde P pole S 60 E 59.88'
 Nail & K.C. Remon tag N sde MBT pole S 75 W 99.88'
 Nail & K.C. Remon tag S sde P pole N 65 E 79.62'
 SW cor of hse #5227 (conc block) N 25 W 65.22'
 SE cor of hse #5227 (stone) N 10 E 64.92'
 K.C. Mon at S 1/4 cor sec 31 N 90 W 184.82'

The selected location is accepted by me and is generally accepted by professional surveyors as the best available evidence of the position of the original corner.

C. Description of monument for corner and accessories established to perpetuate locating the position of the corner:

B-1 Standard Kent County Monument
 Nail & K.C. remon. tag on E side P. pole S 60° E 59.88'
 Nail & K.C. remon. tag on N side MBT pole S 75° W 99.88'
 Nail & K.C. remon. tag on S side P. pole N 65° E 79.62'
 SW cor. hse. #5227 (conc. block) N 25° W 65.22'
 SE cor. hse. #5227 (stone) N 10° E 64.92'
 K.C. Mon., B-13, T9N, R10W, N 90° W 184.82'

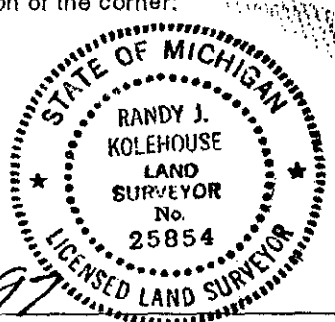

Signed by Randy J. Kolehouse Date 8/12/97
 EARTH TECH

Surveyor's Michigan License No. 25854