

SURVEY & REMONUMENTATION

\$7.00
\$2.00

MAR 03 1998

LAND CORNER RECORDATION CERTIFICATE
Filing Requirement of Act 74, Mich. P.A. 1970
KENT COUNTY REMONUMENTATION

For corners in **SECTION**

Kent (County)	Located in:	Cannon Township	Corner Code #
1. Public Land Survey	T <u>8N</u>	R <u>10W</u>	<u>B-2</u>
	T _____	R _____	_____
	T _____	R _____	_____
	T _____	R _____	_____
2. Property Controlling in Section	S _____	T _____	R _____
	S _____	T _____	R _____
3. Miscellaneous Property in Sec.	S _____	T _____	R _____
	S _____	T _____	R _____

REG. OF DEEDS

Lucy St. Paul

97 DEC 15 AM 10:43

STATE OF MICHIGAN
COUNTY OF KENT
RECEIVED FOR RECORD


10383

Register of Deeds Stamp & File Number

- 4. Lot No. _____, Recorded Plat _____
- 5. Private Claims _____

I, Randy Kolehouse, in a field survey on June 10 19 97, do hereby certify that under requirements of P.A. 74 Michigan P.A. of 1970, the corner points mentioned in lines 1 and 2 above were in conformance with regulations and rules therefore as required in the current manual of survey instructions of the United States Department of the interior, Bureau of Land Management or by a decree of a Court of Law and/or that the corner points mentioned in lines 3, 4 and 5 above were in conformance with the rules of the Michigan Board of Land Surveyors or by a Decree of a Court of Law; established, re-established, monumented, re-monumented, recovered, found as expressed below:

NOTE: Not more than 4 corners, all in the same town and range, may be recorded on this certificate.

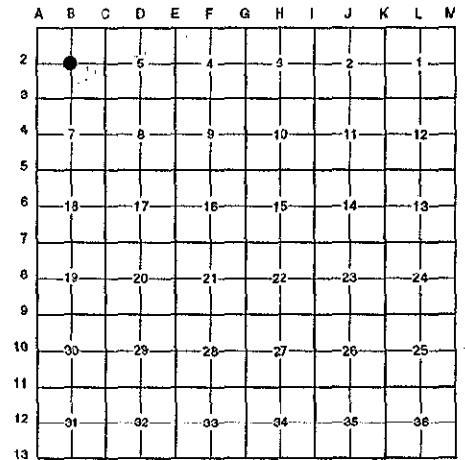

A. Description of original monument and accessories and/or subsequent restoration:

B-2 This corner was not originally set by the G.L.O.

N/A	Witness Map	K.C. Surveyor	Monument Box
1959	Survey Notes	Williams & Works	Set Point @ Int. 1/4 Lines
1973	Survey Notes	Williams & Works	Set "T" Iron @ Int. 1/4 Lines
1973	L.C.R.C. #583	Williams & Works	Fnd. Monument Box / Set "T" Iron @ Int. of 1/4 Lines

B. Description of corner evidence found and/or method applied in restoring or reestablishing corner:

B-2 Found a "T" iron 3' East of the C/L of Courtland Blvd. (bit.) running North and South and 10' ± South of the C/L of Kies Road (bit.) running East (and 5.3' South of a monument box with a 1/2" iron pipe) per L.C.R.C. #583 as set by Williams & Works at the intersection of 1/4 lines. "T" iron is 0.1' East of the intersection of 1/4 lines. Accepted "T" iron as Center of Section.

L.C.R.C. #583

CP pole S70°E 75.20' (m. 75.23')
NW cor gar S35°E 73.34'
Mon box 5. 17' N & 0.4' W

P.A. 345 1990 KENT COUNTY

PEER APPROVED 10/30/97


CHAIRMAN *Harry J. Huber*

The selected location is accepted by me and is generally accepted by professional surveyors as the best available evidence of the position of the original corner.

C. Description of monument for corner and accessories established to perpetuate locating the position of the corner:

B-2 Replaced "T" Iron with a Standard Kent County Monument

- Nail & K.C. remon. tag on S side CP pole S 70° E 75.23'
- NW cor. garage S 35° E 73.34'
- Nail & K.C. remon. tag on N side P. pole S 85° W 28.27'
- Nail & K.C. remon. tag on W side P. pole N 22° E 124.12'
- Iron in Monument Box North 5.3'

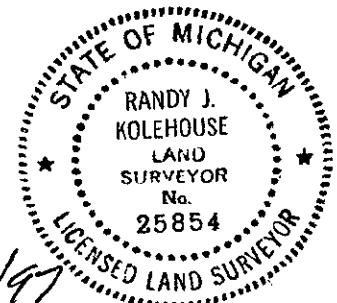

Signed by *Randy J. Kolehouse*
EARTH TECH

Date 11/24/97

Surveyor's Michigan License No. 25854