

SURVEY & REMONUMENTATION

MAR 03 1998

SECTION

LAND CORNER RECORDATION CERTIFICATE
 Filing Requirement of Act 74, Mich. P.A. 1970
 KENT COUNTY REMONUMENTATION

For corners in

| Kent (County) | Located in: Cannon Township | Corner Code # |
|------------------------------------|-----------------------------|---------------|
| 1. Public Land Survey | T <u>8N</u> R <u>10W</u> | <u>B-4</u> |
| | T _____ R _____ | _____ |
| | T _____ R _____ | _____ |
| | T _____ R _____ | _____ |
| 2. Property Controlling in Section | S _____ T _____ R _____ | _____ |
| | S _____ T _____ R _____ | _____ |
| 3. Miscellaneous Property in Sec. | S _____ T _____ R _____ | _____ |
| | S _____ T _____ R _____ | _____ |


STATE OF MICHIGAN
 COUNTY OF KENT
 RECEIVED FOR RECORD
 97 DEC 15 AM 10:43
 REG. OF DEEDS
Luigi Bond

10384

Register of Deeds Stamp & File Number

4. Lot No. _____, Recorded Plat _____
 5. Private Claims _____

I, Randy Kolehouse, in a field survey on October 30 19 97, do hereby certify that under requirements of P.A. 74 Michigan P.A. of 1970, the corner points mentioned in lines 1 and 2 above were in conformance with regulations and rules therefore as required in the current manual of survey instructions of the United States Department of the interior, Bureau of Land Management or by a decree of a Court of Law and/or that the corner points mentioned in lines 3, 4 and 5 above were in conformance with the rules of the Michigan Board of Land Surveyors or by a Decree of a Court of Law; established, re-established, monumented, re-monumented, recovered, found as expressed below:

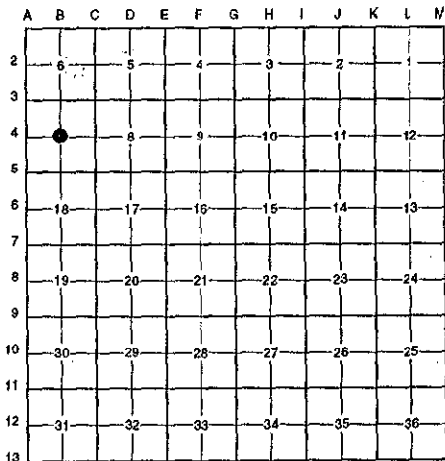

NOTE: Not more than 4 corners, all in the same town and range, may be recorded on this certificate.

A. Description of original monument and accessories and/or subsequent restoration:

B-4 This corner was not originally set by the G.L.O.

1979 L.C.R.C. #1374 Medema, Van Kooten & Assoc. Set Capped Iron

P.A. 345 1990 KENT COUNTY
 PEER APPROVED 10/30/97
 CHAIRMAN *Harry Huber*

B. Description of corner evidence found and/or method applied in restoring or reestablishing corner:

B-4 Found a capped iron (MVK) 2' East of a fence line running North and 2.5' North of a fence line running East per L.C.R.C. #1374. Capped Iron is 0.3' South and 1.0' East of the intersection of 1/4 lines. Accepted capped iron as Center of Section.

L.C.R.C. #1374


- Nail in 20" Oak E-SE 15.80' (m. 15.74')
- Nail in 16" Tw. Oak N-NW 24.93' (m. 24.98')
- Nail in 8" Maple W-NW 7.95' (m. 7.90')

The selected location is accepted by me and is generally accepted by professional surveyors as the best available evidence of the position of the original corner.

C. Description of monument for corner and accessories established to perpetuate locating the position of the corner:

B-4 Replaced Capped Iron with a Standard Kent County Monument

- Nail & K.C. remon. tag on E side 10" Maple S 15° E 23.13'
- Nail & K.C. remon. tag on N side 24" Oak S 70° E 15.74'
- Nail & K.C. remon. tag on W side 18" Twin Oak N 15° West 24.98'
- Nail & K.C. remon. tag on N side 10" Maple N 60° W 7.90'

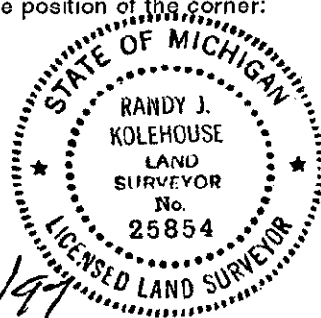

Signed by *Randy J. Kolehouse*
 EARTH TECH

Date 11/24/97

Surveyor's Michigan License No. 25854