

SURVEY & REMONUMENTATION

MAR 03 1998

SECTION

LAND CORNER RECORDATION CERTIFICATE
Filing Requirement of Act 74, Mich. P.A. 1970
KENT COUNTY REMONUMENTATION

For corners in

Kent (County)	Located in:	Cannon Township	Corner Code #
1. Public Land Survey	T <u>8N</u>	R <u>10W</u>	<u>B-9</u>
	T _____	R _____	_____
	T _____	R _____	_____
	T _____	R _____	_____
2. Property Controlling in Section	S _____	T _____	R _____
	S _____	T _____	R _____
3. Miscellaneous Property in Sec.	S _____	T _____	R _____
	S _____	T _____	R _____

REG. OF DEEDS

Rob Jonker

97 OCT 15 AM 8:43

STATE OF MICHIGAN
 COUNTY OF KENT
 RECEIVED FOR RECORD


10081

Register of Deeds Stamp & File Number

4. Lot No. _____, Recorded Plat _____
 5. Private Claims _____

I, Randy Kolehhouse, in a field survey on June 9 19 97, do hereby certify that under requirements of P.A. 74 Michigan P.A. of 1970, the corner points mentioned in lines 1 and 2 above were in conformance with regulations and rules therefore as required in the current manual of survey instructions of the United States Department of the interior, Bureau of Land Management or by a decree of a Court of Law and/or that the corner points mentioned in lines 3, 4 and 5 above were in conformance with the rules of the Michigan Board of Land Surveyors or by a Decree of a Court of Law; established, re-established, monumented, re-monumented, recovered, found as expressed below:

NOTE: Not more than 4 corners, all in the same town and range, may be recorded on this certificate.

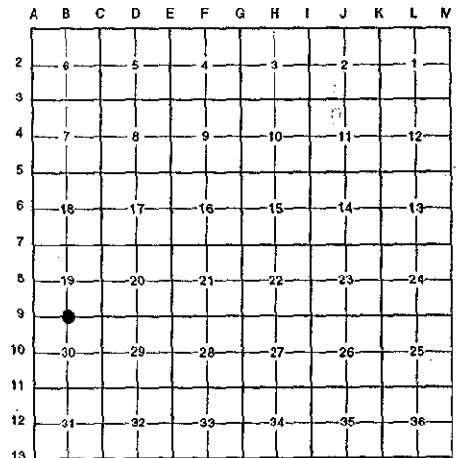

A. Description of original monument and accessories and/or subsequent restoration:

B-9	1831	G.L.O. Notes	Mullett	Set Post
	N/A	Witness Map	K.C. Surveyor	Iron
	1975	L.C.R.C. #843	Williams & Works	1/2" Iron in Monument Box
	1981	L.C.R.C. #2356	Jonker Land Surveys	Fnd. 1/2" Iron in Mon. Box / Set K.C. Monument in Mon. Box
	1992	L.C.R.C. #6271	Chris Marschall	K.C. Monument in Mon. Box

This corner was originally approved by the Kent County Remonumentation Peer Group and monumented by Rob Jonker on 11/13/81 and was recorded per L.C.R.C. #2356.

B. Description of corner evidence found and/or method applied in restoring or reestablishing corner:

B-9 Found a Standard Kent County Monument in a monument box 1' North of the C/L of Cannonsburg Road (bit.) running East and West on line of a tree row running North and South per L.C.R.C.'s #2356 and #6271 as set by Rob Jonker in place of a 1/2" iron he found in a monument box which checked L.C.R.C. #843 and the K.C. Surveyor's records.

L.C.R.C. #2356

L.C.R.C. #6271

Remon. tag on W side p.pole S30°E 65.78'
 Remon. tag on SE side 8" Oak S52°W 88.07'
 Remon. tag on E side cor. fence post N03°E 49.35'
 1/2" round iron S03°W 60.2'


Nail & Tag W sd. U.P. (7' above grd.) S 32 E 65.72'
 Nail & Tag E sd. 8" W. Cherry (5' above grd.) S 49 W 87.94' (m. 54.17')
 Nail & Tag SE sd. 14" Oak (7' above grd.) S 49 W 87.94' (m. 88.02')
 Nail & Tag SW sd. 4" Oak N 48 W 74.65' (m. 74.70')

The selected location is accepted by me and is generally accepted by professional surveyors as the best available evidence of the position of the original corner.

C. Description of monument for corner and accessories established to perpetuate locating the position of the corner:

B-9 Standard Kent County Monument in a Monument Box

Nail & K.C. remon. tag on W side U.P. pole (7' above gnd.) S 32° E 65.72'
 Nail & K.C. remon. tag on E side 8" White Cherry (5' above gnd.) S 01° E 54.17'
 Nail & K.C. remon. tag on SE side 14" Oak (7' above gnd.) S 49° W 88.02'
 Nail & K.C. remon. tag on SW side 4" Oak N 48° W 74.70'
 1/2" round iron S 03° W 50.2'

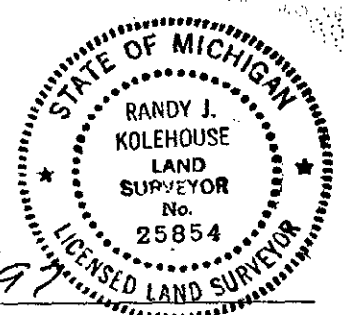

Signed by Randy J. Kolehhouse Date 8/12/97

EARTH TECH

Surveyor's Michigan License No. 25854

P.A. 345 1990 KENT COUNTY
 PEER APPROVED 6/26/97
 CHAIRMAN Randy Kolehhouse