

# SURVEY & REMONUMENTATION

MAR 03 1998

## LAND CORNER RECORDATION CERTIFICATE Filing Requirement of Act 74, Mich. P.A. 1970 KENT COUNTY REMONUMENTATION

For corners in **SECTION**

| Kent<br>(County)                      | Located in:<br>Cannon<br>Township | Corner Code # |
|---------------------------------------|-----------------------------------|---------------|
| 1. Public Land Survey                 | T <u>8N</u> R <u>10W</u>          | <u>B-11</u>   |
|                                       | T _____ R _____                   | _____         |
|                                       | T _____ R _____                   | _____         |
|                                       | T _____ R _____                   | _____         |
| 2. Property Controlling<br>in Section | S _____ T _____ R _____           | _____         |
|                                       | S _____ T _____ R _____           | _____         |
| 3. Miscellaneous<br>Property in Sec.  | S _____ T _____ R _____           | _____         |
|                                       | S _____ T _____ R _____           | _____         |

REG. OF DEEDS

*Luci J. Bond*

97 OCT 15 AM 8:44


STATE OF MICHIGAN  
COUNTY OF KENT  
RECEIVED FOR RECORD

**10082**

Register of Deeds Stamp & File Number

4. Lot No. \_\_\_\_\_, Recorded Plat \_\_\_\_\_  
5. Private Claims \_\_\_\_\_

I, Randy Kolehouse, in a field survey on June 9 19 97, do hereby certify that under requirements of P.A. 74 Michigan P.A. of 1970, the corner points mentioned in lines 1 and 2 above were in conformance with regulations and rules therefore as required in the current manual of survey instructions of the United States Department of the interior, Bureau of Land Management or by a decree of a Court of Law and/or that the corner points mentioned in lines 3, 4 and 5 above were in conformance with the rules of the Michigan Board of Land Surveyors or by a Decree of a Court of Law; established, re-established, monumented, re-monumented, recovered, found as expressed below:

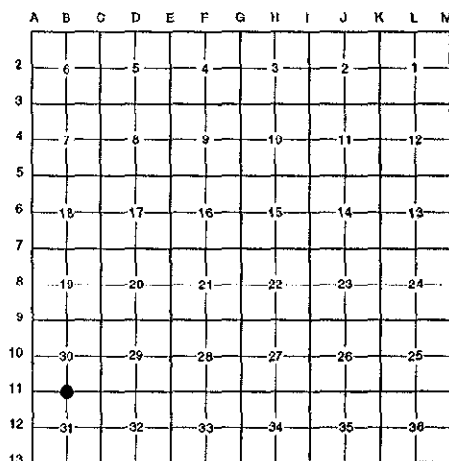

**NOTE: Not more than 4 corners, all in the same town and range, may be recorded on this certificate.**

**A. Description of original monument and accessories and/or subsequent restoration:**

|      |      |                |                     |                                      |
|------|------|----------------|---------------------|--------------------------------------|
| B-11 | 1831 | G.L.O. Notes   | Mullett             | Set Post                             |
|      | 1937 | Witness Map    | K.C. Surveyor       | Monument - Iron Above                |
|      | 1974 | L.C.R.C. #778  | G. Nederveld        | 3" Iron in Corner Fence Post         |
|      | 1974 | L.C.R.C. #926  | Williams & Works    | 3" Steel Fence Post                  |
|      | 1982 | L.C.R.C. #2814 | Jonker Land Surveys | 3" Steel Fence Post in Concrete Base |
|      | 1991 | L.C.R.C. #6272 | Chris Marschall     | 3" Steel Fence Post in Concrete Base |

**B. Description of corner evidence found and/or method applied in restoring or reestablishing corner:**

B-11 Found a 3" diameter by 4'6" high steel fence post (corner post of fence running North and East) 50' ± West of the C/L intersection of Chauncey Road (gravel) running North and 5 Mile Road (bit.) running East per L.C.R.C.'s #6272, #2814, #926, and #778.

L.C.R.C. #6272

Sq. spk on SE sd. 54" Ash (5' above grd) S 35 W 123.00' (m. 123.12')  
SE corner garage N 55 W 93.21'  
SE corner Fr. Bldg S 80 W 80.29'  
C/L MBT ped. N 10 E 24.29'

P.A. 345 1990 KENT COUNTY

PEER APPROVED 6/26/97


CHAIRMAN *[Signature]*

The selected location is accepted by me and is generally accepted by professional surveyors as the best available evidence of the position of the original corner.

**C. Description of monument for corner and accessories established to perpetuate locating the position of the corner:**

B-11 3" Diameter by 4.6' High Steel Fence Post (in Concrete)

Nail & K.C. remon. tag on SE side 54" Ash (6' above grade) S 35° W 123.12'  
SE cor. garage N 55° W 93.21'  
SE cor. frame building S 80° W 80.29'  
C/L MBT box N 10° E 24.29'

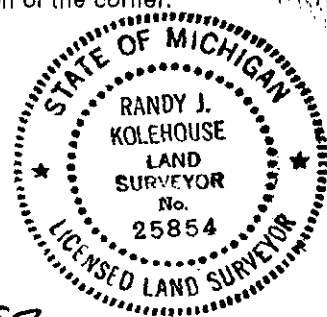

Signed by Randy J. Kolehouse

Date 8/12/97

Surveyor's Michigan License No. 25854