

SURVEY & REMONUMENTATION

MAR 03 1998

\$7.00
\$2.00

SECTION

LAND CORNER RECORDATION CERTIFICATE
Filing Requirement of Act 74, Mich. P.A. 1970
KENT COUNTY REMONUMENTATION

REG. OF DEEDS

Lucy Bond

97 DEC 15 AM 10:43

STATE OF MICHIGAN
COUNTY OF KENT
RECEIVED FOR RECORD

For corners in

Kent (County)	Located in:	Cannon Township	Corner Code #
1. Public Land Survey	T	8N R 10W	E-12
	T	R	
	T	R	
	T	R	
2. Property Controlling in Section	S	T R	
	S	T R	
3. Miscellaneous Property in Sec.	S	T R	
	S	T R	

10387

Register of Deeds Stamp & File Number


- 4. Lot No. _____, Recorded Plat _____
- 5. Private Claims _____

I, Randy Kolehouse, in a field survey on October 18 19 97, do hereby certify that under requirements of P.A. 74 Michigan P.A. of 1970, the corner points mentioned in lines 1 and 2 above were in conformance with regulations and rules therefore as required in the current manual of survey instructions of the United States Department of the Interior, Bureau of Land Management or by a decree of a Court of Law and/or that the corner points mentioned in lines 3, 4 and 5 above were in conformance with the rules of the Michigan Board of Land Surveyors or by a Decree of a Court of Law; established, re-established, monumented, re-monumented, recovered, found as expressed below:

NOTE: Not more than 4 corners, all in the same town and range, may be recorded on this certificate.

A. Description of original monument and accessories and/or subsequent restoration:

- E-12 This corner was not originally set by the G.L.O.
- 1909 Survey Records Williams & Works Set Center "on 1/4 line" 2605 North of S 1/4
- 1943 Survey Records Williams & Works Fence Corner
- 1958 Survey Records Williams & Works Set Fence Post

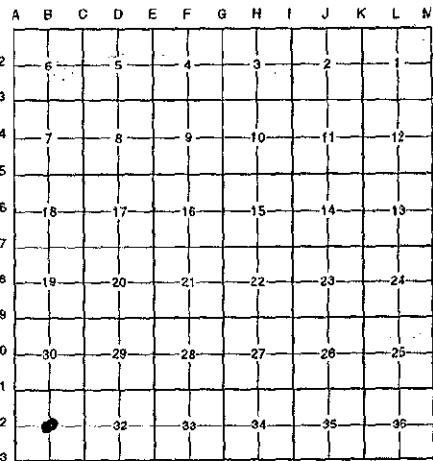

B. Description of corner evidence found and/or method applied in restoring or reestablishing corner:

- 12 Found a steel fence post in an old fence line running East and West and three witness nails. No information has been recorded for this corner. Fence post is 2608.83 North of the South 1/4 corner, 2669.05' West of the East 1/4 corner, and 0.2' West of the North-South 1/4 lines. Accepted fence post as Center of Section.

P.A. 345 1990 KENT COUNTY
PEER APPROVED 11/20/97
CHAIRMAN Harry Huber

The selected location is accepted by me and is generally accepted by professional surveyors as the best available evidence of the position of the original corner.

Description of monument for corner and accessories established to perpetuate location of the corner:

12 Set a Standard Kent County Monument

- Nail & K.C. remon. tag on W side Tw. 24" Oak North 45.43'
- Nail & K.C. remon. tag on N side Tw. 12" Hickory S 65° E 9.69'
- Nail & K.C. remon. tag on W side 12" Oak South 26.18'
- Nail & K.C. remon. tag on N side 36" Oak West 57.83'



Red by *[Signature]* Date 12/8/97

EARTH TECH

Surveyor's Michigan License No. 39086