

SURVEY & REMONUMENTATION

\$7.00
\$2.00

MAR 03 1998

SECTION

LAND CORNER RECORDATION CERTIFICATE
Filing Requirement of Act 74, Mich. P.A. 1970
KENT COUNTY REMONUMENTATION

For corners in

Kent (County)	Located in: Cannon Township	Corner Code #
1. Public Land Survey	T <u>8N</u> R <u>10W</u>	<u>B-13</u>
	T _____ R _____	_____
	T _____ R _____	_____
	T _____ R _____	_____
2. Property Controlling in Section	S _____ T _____ R _____	_____
	S _____ T _____ R _____	_____
3. Miscellaneous Property in Sec.	S _____ T _____ R _____	_____
	S _____ T _____ R _____	_____

REG. OF DEEDS

Lucy J. Bond

97 DEC 15 AM 10:43

STATE OF MICHIGAN
COUNTY OF KENT
RECEIVED FOR RECORD

10388

Register of Deeds Stamp & File Number

4. Lot No. _____, Recorded Plat _____
5. Private Claims _____

I, Randy Kolehouse, in a field survey on November 14 19 97, do hereby certify that under requirements of P.A. 74 Michigan P.A. of 1970, the corner points mentioned in lines 1 and 2 above were in conformance with regulations and rules therefore as required in the current manual of survey instructions of the United States Department of the Interior, Bureau of Land Management or by a decree of a Court of Law and/or that the corner points mentioned in lines 3, 4 and 5 above were in conformance with the rules of the Michigan Board of Land Surveyors or by a Decree of a Court of Law; established, re-established, monumented, re-monumented, recovered, found as expressed below:

NOTE: Not more than 4 corners, all in the same town and range, may be recorded on this certificate.

A. Description of original monument and accessories and/or subsequent restoration:

B-13	1831	G.L.O. Notes	Mullett	Set Post
	1974	L.C.R.C. #778	G. Nederveld	Set 3/4" Iron
	1981	L.C.R.C. #1778	Williams & Works	Fnd. 1" Iron / Set K.C. Monument
	1991	L.C.R.C. #6273	Chris Marschall	K.C. Monument

Note: This corner is not common with B-1, T7N, R10W.

This corner was originally approved by the Kent County Remonumentation Peer Group and monumented by Williams & Works on 1/28/81 and was recorded per L.C.R.C. #1778.

B. Description of corner evidence found and/or method applied in restoring or reestablishing corner:

B-13 Found a Standard Kent County Monument on line of a fence line (remnant) running East and West and 303.4' ± East of B-1, T7N, R10W, per L.C.R.C.'s #1778 and #6273 as set by Williams & Works in place of a 1" x 30" iron they found which checked L.C.R.C. #778 and the K.C. Surveyor's records.

L.C.R.C. #1778

L.C.R.C. #6273

- Nail and K.C. Remon. Tag in NE Side 12" Ash N 55° W 12.38'
- Nail and K.C. Remon. Tag in E Side 14" Ash N 20° W 19.80'
- Nail and K.C. Remon. Tag in E Side 10" Ash N 17° E 26.42'
- Nail and K.C. Remon. Tag in N Side 10" Ash N 60° E 17.49'
- Nail and K.C. Remon. Tag in NE Side 12" Ash S 45° E 32.53'
- Nail and K.C. Remon. Tag in NW Side 18" Ash S 10° W 43.55'
- Nail and K.C. Remon. Tag in N Side 16" Ash S 42° W 55.36'
- Nail and K.C. Remon. Tag in N Side 24" Ash S 75° W 60.33'


- Nail & Tag NE sd. 12" Ash N 55° W 12.29' (m. 12.3')
- Nail & Tag W sd. 14" Ash N 20° W 19.76' (m. 19.9')
- Nail & Tag E sd. 12" Ash N 17° E 26.45' (m. 26.5')
- Nail & Tag N sd. 10" Ash N 60° E 17.65' (m. 17.7')
- Nail & Tag NE sd. 12" Elm S 45° E 32.62' (m. 32.7')
- Nail & Tag NW sd. 22" Ash S 10° W 43.52' (m. 43.5')
- Nail & Tag N sd. 20" Ash S 42° W 55.36' (m. 55.4')
- Nail & Tag N sd. 26" Ash S 75° W 60.33' (m. 60.2')

The selected location is accepted by me and is generally accepted by professional surveyors as the best available evidence of the position of the original corner.

C. Description of monument for corner and accessories established to perpetuate locating the position of the corner:

B-13 Standard Kent County Monument

- Nail & K.C. remon. tag on NE side 12" Ash N 56° W 12.3'
- Nail & K.C. remon. tag on W side 14" Ash N 19° W 19.9'
- Nail & K.C. remon. tag on E side 14" Ash N 20° E 26.5'
- Nail & K.C. remon. tag on N side 10" Ash N 67° E 17.7'
- Nail & K.C. remon. tag on NE side 12" Elm S 40° E 32.7'
- Nail & K.C. remon. tag on NW side 20" Ash S 10° W 43.5'
- Nail & K.C. remon. tag on N side Twin 12" Ash S 43° W 55.4'
- Nail & K.C. remon. tag on N side 22" Ash S 76° W 60.2'

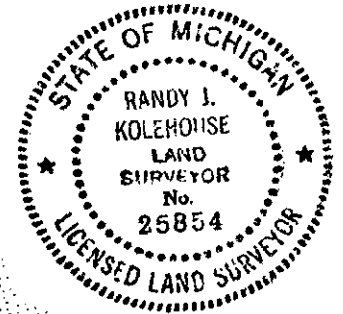

Signed by Randy J. Kolehouse

Date 11/28/97

Surveyor's Michigan License No. 25854

