

SURVEY & REMONUMENTATION

MAR 03 1998

SECTION

LAND CORNER RECORDATION CERTIFICATE
Filing Requirement of Act 74, Mich. P.A. 1970
KENT COUNTY REMONUMENTATION


For corners in

Kent (County)	Located in: Cannon Township	Corner Code #
1. Public Land Survey	T <u>8N</u> R <u>10W</u>	<u>C-1</u>
	T _____ R _____	_____
	T _____ R _____	_____
	T _____ R _____	_____
2. Property Controlling in Section	S _____ T _____ R _____	_____
	S _____ T _____ R _____	_____
3. Miscellaneous Property in Sec.	S _____ T _____ R _____	_____
	S _____ T _____ R _____	_____

STATE OF MICHIGAN
 COUNTY OF KENT
 RECEIVED FOR RECORD
 97 OCT 15 AM 8:44
 REG. OF DEEDS
Lucy Bond

10083
 Register of Deeds Stamp & File Number

4. Lot No. _____, Recorded Plat _____
 5. Private Claims _____

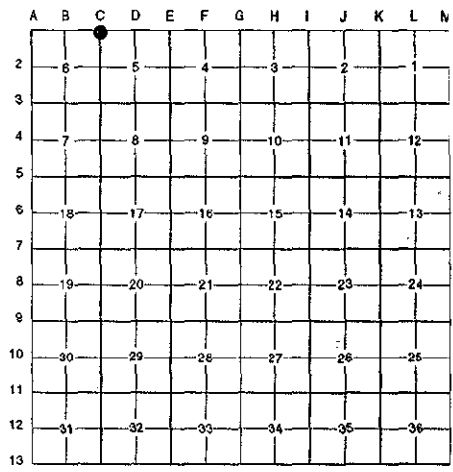

I, Randy Kolehouse, in a field survey on June 10 19 97, do hereby certify that under requirements of P.A. 74 Michigan P.A. of 1970, the corner points mentioned in lines 1 and 2 above were in conformance with regulations and rules therefore as required in the current manual of survey instructions of the United States Department of the interior, Bureau of Land Management or by a decree of a Court of Law and/or that the corner points mentioned in lines 3, 4 and 5 above were in conformance with the rules of the Michigan Board of Land Surveyors or by a Decree of a Court of Law; established, re-established, monumented, re-monumented, recovered, found as expressed below:

NOTE: Not more than 4 corners, all in the same town and range, may be recorded on this certificate.

A. Description of original monument and accessories and/or subsequent restoration:

C-1	1831 K	G.L.O. Notes	Mullett	Set Post
	1928-68	Witness Map	K.C. Surveyor	Iron
	1954-68	Notes	Williams & Works	Iron
	1981	L.C.R.C. #2093	Madema, Van Kooten & Assoc.	1-1/2" Iron
	1984	L.C.R.C. #3978	William Byl	Fnd. 1-1/2" Iron Pipe / Set K.C. Monument
	1988	L.C.R.C. #4840	J. Bueche	K.C. Monument

P.A. 345 1990 KENT COUNTY
PEER APPROVED 6/26/97
 CHAIRMAN *Randy Kolehouse*

Note: This corner is not common with C-13, T9N, R10W.

This corner was originally approved by the Kent County Remonumentation Peer Group and monumented by William Byl on 10/17/84 and was recorded per L.C.R.C. #3978.

B. Description of corner evidence found and/or method applied in restoring or reestablishing corner:

C-1 Found a Standard Kent County Monument on the Town line 200' ± South of 10 Mile Road (bit.) running East and West and 30' ± West of the creek bank running North and South per L.C.R.C.'s #3978 and #4840 as set by William Byl on the Town line 1.59' North of a 1-1/2" iron pipe he found at a fence corner which checked L.C.R.C. #2093, the 1954-68 notes of Williams & Works, and the K.C. Surveyor's records.

L.C.R.C. #3978

L.C.R.C. #4840

Nail & tag, S. sd. 48" Oak N 60 E 45.92'

Nail & tag S sde 50" Oak N 60 E 45.92'

Nail & tag, W. sd. 24" Oak S 20 E 61.72'

Nail & tag W sde 26" Oak S 20 E 61.72'

Nail & tag, S. sd. 15" Oak N 70 W 13.86'

Nail & tag S sde 17" Oak N 70 W 13.86'

Nail & tag E. sd. 12" Twin Oak S 40 W 12.67'

Nail & tag E sde 14" Twin Oak S 40 W 12.67'

SE'ly cor. house foundation N 40 E 85.25'

SE'ly cor house #5600 fndn N 40 E 85.25'

The selected location is accepted by me and is generally accepted by professional surveyors as the best available evidence of the position of the original corner.

C. Description of monument for corner and accessories established to perpetuate locating the position of the corner:

C-1 Standard Kent County Monument

Nail & K.C. remon. tag on S side 50" Oak N 60° E 45.92'

SE'ly cor. hse. #5600 fndn. N 40° E 85.25'

Nail & K.C. remon. tag on W side 26" Oak S 20° E 61.72'

1-1/2" iron pipe South 1.59'

Nail & K.C. remon. tag on S side 18" Oak N 70° W 13.86'

SE corner Sec. 31, T9N, R10W, East 184.88'

Nail & K.C. remon. tag on E side 14" Twin Oak S 40° W 12.67'

Signed by *Randy J. Kolehouse* Date 8/12/97

EARTH TECH

Surveyor's Michigan License No. 25854

