

SURVEY & REMONUMENTATION

MAR 03 1998

LAND CORNER RECORDATION CERTIFICATE Filing Requirement of Act 74, Mich. P.A. 1970 KENT COUNTY REMONUMENTATION

STATE OF MICHIGAN
 COUNTY OF KENT
 RECEIVED FOR RECORD
 97 OCT 15 AM 8:44
 REG. OF DEEDS
Lucy Spindel

SECTION

For corners in

Kent (County)	Located in:	Cannon Township	Corner Code #
1. Public Land Survey	T <u>8N</u>	R <u>10W</u>	<u>C-2</u>
	T _____	R _____	_____
	T _____	R _____	_____
	T _____	R _____	_____
2. Property Controlling in Section	S _____	T _____	R _____
	S _____	T _____	R _____
3. Miscellaneous Property in Sec.	S _____	T _____	R _____
	S _____	T _____	R _____

10084

Register of Deeds Stamp & File Number

4. Lot No. _____, Recorded Plat _____
 5. Private Claims _____

I, Randy Kolehouse, in a field survey on June 10 19 97, do hereby certify that under requirements of P.A. 74 Michigan P.A. of 1970, the corner points mentioned in lines 1 and 2 above were in conformance with regulations and rules therefore as required in the current manual of survey instructions of the United States Department of the interior, Bureau of Land Management or by a decree of a Court of Law and/or that the corner points mentioned in lines 3, 4 and 5 above were in conformance with the rules of the Michigan Board of Land Surveyors or by a Decree of a Court of Law; established, re-established, monumented, re-monumented, recovered, found as expressed below:


NOTE: Not more than 4 corners, all in the same town and range, may be recorded on this certificate.

A. Description of original monument and accessories and/or subsequent restoration:

C-2	1831	G.L.O. Notes	Mullett	Set Post
	N/A	Witness Map	K.C. Surveyor	"T" Iron
	1973	L.C.R.C. #583	Williams & Works	Monument Box
	1975	L.C.R.C. #823	Williams & Works	Stone
	1980	L.C.R.C. #1472	Williams & Works	Fnd. 1" Round Iron / Set K.C. Monument
	1981	L.C.R.C. #2093	Medema, Van Kooten & Assoc.	K.C. Monument
	1991	L.C.R.C. #6274	Chris Marschall	K.C. Monument

P.A. 345 1990 KENT COUNTY

PEER APPROVED 6/26/97
 CHAIRMAN Randy Kolehouse

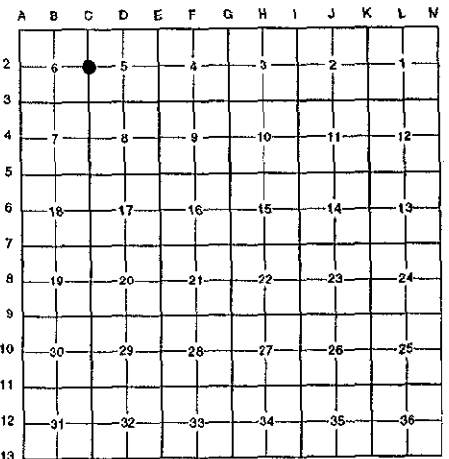

This corner was originally approved by the Kent County Remonumentation Peer Group and monumented by Williams & Works on 10/31/80 and was recorded per L.C.R.C. #1472.

B. Description of corner evidence found and/or method applied in restoring or reestablishing corner:

C-2 Found a Standard Kent County Monument in a monument box 1' North of the C/L intersection of Kies Street (bit.) running East and West and Blakely Drive (bit.) running South on line of a tree row running North per L.C.R.C.'s #1472, #2093 and #6274 as set by Williams & Works in place of a 1" round iron 9" long they found on top of a "T" iron 18" long in a monument box which checked L.C.R.C.'s #823, #583 and the K.C. Surveyor's records.

L.C.R.C. #1472

L.C.R.C. #6274

Nail & K.C. Remon. Tag SE Side Power Pole S 75°W 108.11'
 Nail & K.C. Remon. Tag North Side 20" Oak S 50°E 77.78'


Nail & Tag SW sd. 20" Oak S 55 E 77.78'
 Nail & Tag W sd. 18" Oak N 5 E 32.49'
 Nail & Tag NW sd. 20" Oak N 35 E 37.98'
 Nail & Tag N sd. P.P. S 75 W 108.00'
 Nail & Tag S sd. U.P. N 70 W 80.43'

The selected location is accepted by me and is generally accepted by professional surveyors as the best available evidence of the position of the original corner.

C. Description of monument for corner and accessories established to perpetuate locating the position of the corner:

C-2 Standard Kent County Monument in a Monument Box

Nail & K.C. remon. tag on SW side 20" Oak S 55° E 77.78'
 Nail & K.C. remon. tag on SW side 20" Oak N 35° E 37.98'
 Nail & K.C. remon. tag on N side P. pole S 75° W 108.0'
 Nail & K.C. remon. tag on S side Util. pole N 70° W 80.43'

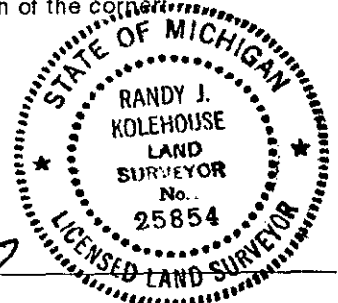

Signed by Randy J. Kolehouse Date 8/12/97

Surveyor's Michigan License No. 25854