

SURVEY & REMONUMENTATION

MAR 03 1998

SECTION

LAND CORNER RECORDATION CERTIFICATE
Filing Requirement of Act 74, Mich. P.A. 1970
KENT COUNTY REMONUMENTATION

For corners in

Kent (County)	Located in: Cannon Township	Corner Code #
1. Public Land Survey	T <u>8N</u> R <u>10W</u>	<u>C-3</u>
	T _____ R _____	_____
	T _____ R _____	_____
	T _____ R _____	_____
2. Property Controlling in Section	S _____ T _____ R _____	_____
	S _____ T _____ R _____	_____
3. Miscellaneous Property in Sec.	S _____ T _____ R _____	_____
	S _____ T _____ R _____	_____

STATE OF MICHIGAN
 COUNTY OF KENT
 RECEIVED FOR RECORD
 97 OCT 15 AM 8:44
 REG. OF DEEDS
David Bond

10085

Register of Deeds Stamp & File Number


4. Lot No. _____, Recorded Plat _____
 5. Private Claims _____

I, Randy Kolehouse, in a field survey on June 10 19 97, do hereby certify that under requirements of P.A. 74 Michigan P.A. of 1970, the corner points mentioned in lines 1 and 2 above were in conformance with regulations and rules therefore as required in the current manual of survey instructions of the United States Department of the interior, Bureau of Land Management or by a decree of a Court of Law and/or that the corner points mentioned in lines 3, 4 and 5 above were in conformance with the rules of the Michigan Board of Land Surveyors or by a Decree of a Court of Law; established, re-established, monumented, re-monumented, recovered, found as expressed below:

NOTE: Not more than 4 corners, all in the same town and range, may be recorded on this certificate.

A. Description of original monument and accessories and/or subsequent restoration:

C-3	1831	G.L.O. Notes	Mullett	Set Post
	N/A	Witness Map	K.C. Surveyor	Iron
	1973	L.C.R.C. #583	Williams & Works	"T" Iron
	1975	L.C.R.C. #823	Williams & Works	Iron
	1981	L.C.R.C. #2357	Jonker Land Surveys	Fnd. "T" Iron / Set K.C. Monument
	1991	L.C.R.C. #6275	Chris Marschall	K.C. Monument

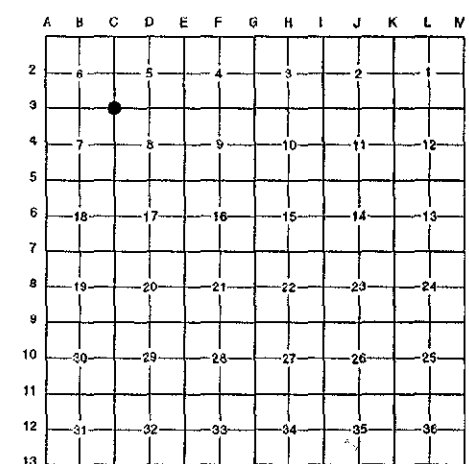

P.A. 345 1990 KENT COUNTY
 PEER APPROVED 6/26/97
 CHAIRMAN Harry Huber


This corner was originally approved by the Kent County Remonumentation Peer Group and monumented by Rob Jonker on 11/11/81 and was recorded per L.C.R.C. #2357.

B. Description of corner evidence found and/or method applied in restoring or reestablishing corner:
 C-3 Found a Standard Kent County Monument at the C/L intersection of Blakely Drive (bit.) running North and South and 9 Mile Road (bit.) running East per L.C.R.C.'s #2357 and #6275 as set by Rob Jonker in place of a "T" iron he found which checked L.C.R.C.'s #823, #583 and the K.C. Surveyor's records.

L.C.R.C. #2357	L.C.R.C. #6275
Remon. tag on E side 28" Maple N20°W 53.35'	Nail & Tag E sd. 28" Maple N 20 W 53.29'
Remon. tag on NW side fence post N52°E 52.76'	Nail & Tag E sd. 28" Maple N 15 W 100.05'
Remon. tag on S side 30" Hackberry S68°W 85.01'	Nail & Tag S sd. 38" Hackberry S 68 W 85.00' (m. 85.06')
SE corner hse. fnd. N80°W 74.7'	Nail & Tag SE sd. 12" Tri Box Elder S 25 W 81.93'
	SE Cor. garage N 65 W 102.21'

The selected location is accepted by me and is generally accepted by professional surveyors as the best available evidence of the position of the original corner.

C. Description of monument for corner and accessories established to perpetuate locating the position of the corner:
 C-3 Standard Kent County Monument
 Nail & K.C. remon. tag on E side 30" Maple N 20° W 53.29'
 Nail & K.C. remon. tag on E side 30" Maple N 15° W 100.05'
 Nail & K.C. remon. tag on S side 40" Hackberry S 68° W 85.06'
 Nail & K.C. remon. tag on SE side 14" Tri. Box Elder S 25° W 81.93'
 Nail & K.C. remon. tag on SE side P. pole N 53° E 45.75'
 SE cor. garage N 65° W 102.21'

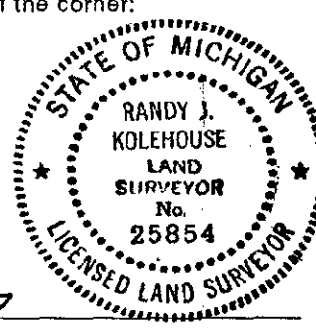

Signed by Randy J. Kolehouse Date 8/12/97
 EARTH TECH

Surveyor's Michigan License No. 25854