

SURVEY & REMONUMENTATION

MAR 03 1998

SECTION

LAND CORNER RECORDATION CERTIFICATE
Filing Requirement of Act 74, Mich. P.A. 1970
KENT COUNTY REMONUMENTATION

For corners in

Kent (County)	Located in: Cannon Township	Corner Code #
1. Public Land Survey	T <u>8N</u> R <u>10W</u>	<u>C-4</u>
	T _____ R _____	_____
	T _____ R _____	_____
	T _____ R _____	_____
2. Property Controlling in Section	S _____ T _____ R _____	_____
	S _____ T _____ R _____	_____
3. Miscellaneous Property in Sec.	S _____ T _____ R _____	_____
	S _____ T _____ R _____	_____

STATE OF MICHIGAN
 COUNTY OF KENT
 RECEIVED FOR RECORD
 97 OCT 15 AM 8:44
 REG. OF DEEDS
Lucy St. Bond

10086

Register of Deeds Stamp & File Number

4. Lot No. _____, Recorded Plat _____
 5. Private Claims _____


I, Randy Kolehouse, in a field survey on June 10 19 97, do hereby certify that under requirements of P.A. 74 Michigan P.A. of 1970, the corner points mentioned in lines 1 and 2 above were in conformance with regulations and rules therefore as required in the current manual of survey instructions of the United States Department of the interior, Bureau of Land Management or by a decree of a Court of Law and/or that the corner points mentioned in lines 3, 4 and 5 above were in conformance with the rules of the Michigan Board of Land Surveyors or by a Decree of a Court of Law; established, re-established, monumented, re-monumented, recovered, found as expressed below:

NOTE: Not more than 4 corners, all in the same town and range, may be recorded on this certificate.

A. Description of original monument and accessories and/or subsequent restoration:

C-4	1831	G.L.O. Notes	Mullett	Set Post
	N/A	Witness Map	K.C. Surveyor	Iron
	1974	L.C.R.C. #776	Nederveld & Jonker	"T" Iron
	1981	L.C.R.C. #2358	Jonker Land Surveys	Fnd. "T" Iron / Set K.C. Monument
	1991	L.C.R.C. #6276	Chris Marschall	K.C. Monument

P.A. 345 1990 KENT COUNTY
 PEER APPROVED 6/26/97
 CHAIRMAN *Randy Kolehouse*

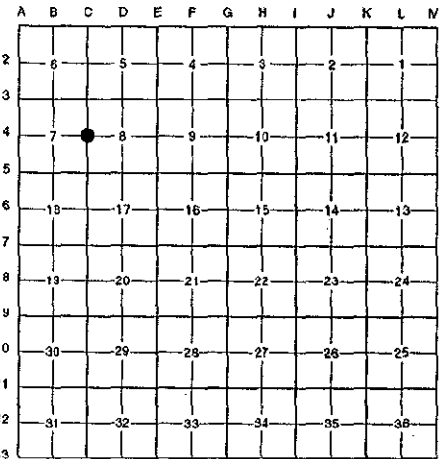

This corner was originally approved by the Kent County Remonumentation Peer Group and monumented by Rob Jonker on 11/10/81 and was recorded per L.C.R.C. #2358.

B. Description of corner evidence found and/or method applied in restoring or reestablishing corner:

C-4 Found a Standard Kent County Monument 12.5' East of the C/L of Blakely Drive (bit.) running North and South in the gravel shoulder on the East side of Blakely and 400' ± South of Arroyo Vista Drive running East per L.C.R.C.'s #2358 and #6276 as set by Rob Jonker in place of a "T" iron he found at grade over a 2" x 4-1/2' bent pipe in a pile of stones 2' below grade which checked L.C.R.C. #776 and the K.C. Surveyor's records.

L.C.R.C. #2358

Remon. tag on N side p. pole S72°W 92.48'
 Remon. tag on SW side 8" Elm N34°W 87.66'

L.C.R.C. #6276


Nail & Tag N sd. P.P. S 72 W 92.69'
 Nail & Tag N sd. 4" Elm N 80 W 52.86'
 Nail & Tag SW sd. 8" Elm N 34 W 87.64'
 Nail & Tag E sd. 6" Tri Elm N 25 W 102.68'

The selected location is accepted by me and is generally accepted by professional surveyors as the best available evidence of the position of the original corner.

C. Description of monument for corner and accessories established to perpetuate locating the position of the corner:

C-4 Standard Kent County Monument

- Nail & K.C. remon. tag on N side T. pole S 72° W 92.69'
- Nail & K.C. remon. tag on N side 4" Elm N 80° W 52.86'
- Nail & K.C. remon. tag on SW side 8" Elm N 34° W 87.64'
- Nail & K.C. remon. tag on E side 6" Triple Elm N 25° W 102.68'

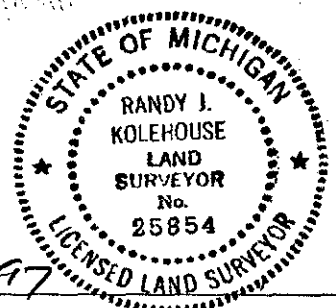

Signed by *Randy J. Kolehouse* Date 8/12/97
 EARTH TECH

Surveyor's Michigan License No. 25854