

MAR 03 1998

SECTION

LAND CORNER RECORDATION CERTIFICATE
Filing Requirement of Act 74, Mich. P.A. 1970
KENT COUNTY REMONUMENTATION

For corners in

Kent
(County)

Located in: Cannon Township Corner Code #

- 1. Public Land Survey T 8N R 10W C-7
T _____ R _____
T _____ R _____
T _____ R _____
- 2. Property Controlling in Section S _____ T _____ R _____
S _____ T _____ R _____
- 3. Miscellaneous Property in Sec. S _____ T _____ R _____
S _____ T _____ R _____


- 4. Lot No. _____, Recorded Plat _____
- 5. Private Claims _____

STATE OF MICHIGAN
 COUNTY OF KENT
 RECEIVED FOR RECORD
 97 OCT 15 AM 8:44
 REG. OF DEEDS
Lucy Stand

10089

Register of Deeds Stamp & File Number

I, Randy Kolehouse, in a field survey on June 2 19 97, do hereby certify that under requirements of P.A. 74 Michigan P.A. of 1970, the corner points mentioned in lines 1 and 2 above were in conformance with regulations and rules therefore as required in the current manual of survey instructions of the United States Department of the interior, Bureau of Land Management or by a decree of a Court of Law and/or that the corner points mentioned in lines 3, 4 and 5 above were in conformance with the rules of the Michigan Board of Land Surveyors or by a Decree of a Court of Law; established, re-established, monumented, re-monumented, recovered, found as expressed below:

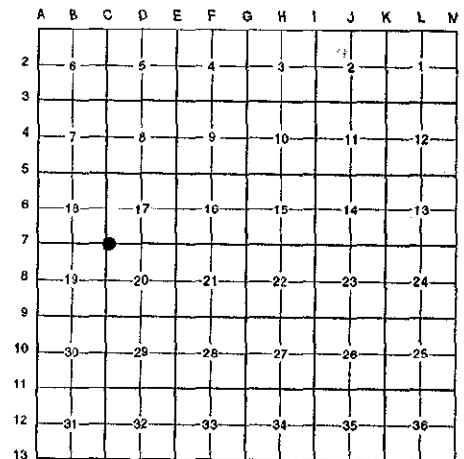

NOTE: Not more than 4 corners, all in the same town and range, may be recorded on this certificate.

A. Description of original monument and accessories and/or subsequent restoration:

C-7	1831	G.L.O. Notes	Mullett	Set Post
	1940	Witness Map	K.C. Surveyor	Concrete Monument
	1974	L.C.R.C. #673	Medema, Van Kooten & Assoc.	Round Iron
	1983	L.C.R.C. #3279	C. Hay	Fnd. 3/4" Iron Over Broken Mon. / Set K.C. Monument
	1991	L.C.R.C. #6279	Chris Marschall	K.C. Monument

This corner was originally approved by the Kent County Remonumentation Peer Group and monumented by C. Hay on 5/18/83 and was recorded per L.C.R.C. #3279.

B. Description of corner evidence found and/or method applied in restoring or reestablishing corner:

C-7 Seven Mile Road has been rebuilt and the K.C. Monument buried 5' ±. Found a P.K. nail 1' North of the C/L of 7 Mile Road (gravel) running Easterly and Westerly which checks L.C.R.C.'s #3279 and #6279.

L.C.R.C. #3279	L.C.R.C. #6279
East side of 12" Oak South 24.99'	Nail & Tag E sd. Tw. 14"-24" Oak (5' above ground) South 25.00' (m. 24.59') Nail & Tag NW sd. 20" Oak (5' above ground) S 20° W 26.95' (m. 26.66')

P.A. 345 1990 KENT COUNTY
PEER APPROVED 6/26/97
CHAIRMAN *Harry Huber*

The selected location is accepted by me and is generally accepted by professional surveyors as the best available evidence of the position of the original corner.

C. Description of monument for corner and accessories established to perpetuate locating the position of the corner:

- C-7 Replaced P.K. Nail with a Standard Kent County Monument
 - Nail & K.C. remon. tag on S side 20" Maple N 53° W 114.57'
 - Nail & K.C. remon. tag on N side P. pole S 80° E 118.72'
 - Nail & K.C. remon. tag on E side Twin 14"-24" Oak 2' above gnd. South 24.59'
 - Nail & K.C. remon. tag on NW side 20" Oak 2' above gnd. S 20° W 26.66'



Signed by Randy J. Kolehouse Date 8/12/97
EARTH TECH

Surveyor's Michigan License No. 25854