

SURVEY & REMONUMENTATION

MAR 03 1998

SECTION

LAND CORNER RECORDATION CERTIFICATE
Filing Requirement of Act 74, Mich. P.A. 1970
KENT COUNTY REMONUMENTATION

For corners in

Kent (County)	Located in: Cannon Township	Corner Code #
1. Public Land Survey	T <u>8N</u> R <u>10W</u>	<u>C-9</u>
	T _____ R _____	_____
	T _____ R _____	_____
	T _____ R _____	_____
2. Property Controlling in Section	S _____ T _____ R _____	_____
	S _____ T _____ R _____	_____
3. Miscellaneous Property in Sec.	S _____ T _____ R _____	_____
	S _____ T _____ R _____	_____


STATE OF MICHIGAN
 COUNTY OF KENT
 RECEIVED FOR RECORD
 97 OCT 15 AM 8:44
 REG. OF DEEDS
Luis J. Bond

10090

Register of Deeds Stamp & File Number

4. Lot No. _____, Recorded Plat _____
 5. Private Claims _____

I, Randy Kolehouse, in a field survey on June 10 19 97, do hereby certify that under requirements of P.A. 74 Michigan P.A. of 1970, the corner points mentioned in lines 1 and 2 above were in conformance with regulations and rules therefore as required in the current manual of survey instructions of the United States Department of the interior, Bureau of Land Management or by a decree of a Court of Law and/or that the corner points mentioned in lines 3, 4 and 5 above were in conformance with the rules of the Michigan Board of Land Surveyors or by a Decree of a Court of Law; established, re-established, monumented, re-monumented, recovered, found as expressed below:

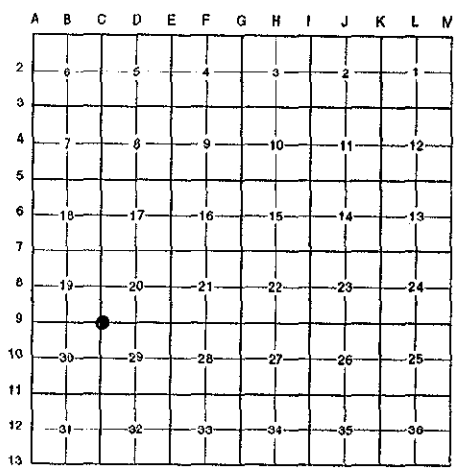

NOTE: Not more than 4 corners, all in the same town and range, may be recorded on this certificate.

A. Description of original monument and accessories and/or subsequent restoration:

C-9	1831	G.L.O. Notes	Mullett	Set Post
	1953	Witness Map	K.C. Surveyor	Iron
	1977	L.C.R.C. #1049	Williams & Works	3/4" Iron in Monument Box
	1981	L.C.R.C. #2361	Jonker Land Surveys	Fnd. 3/4" Iron in Mon. Box / Set K.C. Monument in Mon. Box
	1992	L.C.R.C. #6281	Chris Marschall	K.C. Monument


This corner was originally approved by the Kent County Remonumentation Peer Group and monumented by Rob Jonker on 11/13/81 and was recorded per L.C.R.C. #2361.

B. Description of corner evidence found and/or method applied in restoring or reestablishing corner:
 C-9 Found a Standard Kent County Monument in a monument box on the C/L intersection of Cannonsburg Road (bit.) running East and West and Pettis Avenue (bit.) running South per L.C.R.C.'s #2361 and #6281 as set by Rob Jonker in place of a 3/4" Iron he found in a monument box which checked L.C.R.C. #1049 and the K.C. Surveyor's records.

L.C.R.C. #2361	L.C.R.C. #6281
R. tag on SW side p. pole N45°E 57.8'	Nail & Tag SW sd. U.P. W 44 E 57.76'
SE corner brick house N45°W 85.25'	SE corner brick hse. N 49 W 85.20'
C/L M.H. S04°W 18.29'	Nail & Tag W sd. 16" crab apple S 69 E 129.28' (m. 129.31')
NE corner of catch basin at back curb S22°E 59.8'	Top center MBT box S 42 E 74.24' (m. 74.26')
SW corner of back of curb S25°W 66.09'	NE corner catch basin at back curb S 27 E 59.75'

The selected location is accepted by me and is generally accepted by professional surveyors as the best available evidence of the position of the original corner.

C. Description of monument for corner and accessories established to perpetuate locating the position of the corner:
 C-9 Standard Kent County Monument in a Monument Box
 Nail & K.C. remon. tag on SE side U. pole N 44° E 57.76'
 Nail & K.C. remon. tag on N side 16" Crab Apple S 69° E 129.31'
 SE cor. brick hse. #5583 N 49° W 85.20'
 Top center MBT box S 42° E 74.26'
 NE cor. catch basin at back curb S 27° E 59.75'

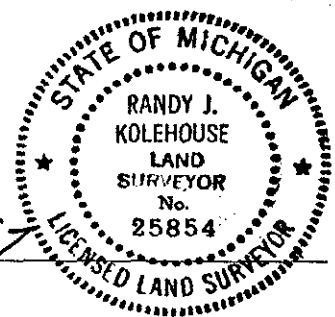

Signed by Randy J. Kolehouse Date 8/12/97
 EARTH TECH

Surveyor's Michigan License No. 25854

P.A. 345 1990 KENT COUNTY
 PEER APPROVED 6/26/97
 CHAIRMAN James Huber
 FORM APPROVED BY MICHIGAN STATE BOARD OF LAND SURVEYORS, JAN. 28, 1971
 REVISED MAY 14, 1975
 REVISED JAN., 1983