

MAR 03 1998

SECTION

LAND CORNER RECORDATION CERTIFICATE  
Filing Requirement of Act 74, Mich. P.A. 1970  
KENT COUNTY REMONUMENTATION

For corners in

Kent (County)	Located in: Cannon Township	Corner Code #
1. Public Land Survey	T <u>8N</u> R <u>10W</u>	<u>C-10</u>
	T _____ R _____	_____
	T _____ R _____	_____
	T _____ R _____	_____
2. Property Controlling in Section	S _____ T _____ R _____	_____
	S _____ T _____ R _____	_____
3. Miscellaneous Property in Sec.	S _____ T _____ R _____	_____
	S _____ T _____ R _____	_____
4. Lot No. _____, Recorded Plat _____		
5. Private Claims _____		

REG. OF DEEDS  
97 OCT 15 AM 8:44  
STATE OF MICHIGAN  
COUNTY OF KENT  
RECEIVED FOR RECORD

10691

Register of Deeds Stamp & File Number


I, Randy Kolehouse, in a field survey on June 10 19 97, do hereby certify that under requirements of P.A. 74 Michigan P.A. of 1970, the corner points mentioned in lines 1 and 2 above were in conformance with regulations and rules therefore as required in the current manual of survey instructions of the United States Department of the interior, Bureau of Land Management or by a decree of a Court of Law and/or that the corner points mentioned in lines 3, 4 and 5 above were in conformance with the rules of the Michigan Board of Land Surveyors or by a Decree of a Court of Law; established, re-established, monumented, re-monumented, recovered, found as expressed below:

NOTE: Not more than 4 corners, all in the same town and range, may be recorded on this certificate.

A. Description of original monument and accessories and/or subsequent restoration:

C-10	1831	G.L.O. Notes	Mullett	Set Post
	1963	Witness Map	K.C. Surveyor	1" Iron
	1972	L.C.R.C. #181	Williams & Works	3/4" Crimped Iron
	1981	L.C.R.C. #2362	Jonker Land Surveys	End. 3/4" Crimped Iron / Set K.C. Monument
	1992	L.C.R.C. #6282	Chris Marschall	K.C. Monument

P.A. 345 1990 KENT COUNTY  
PEER APPROVED 6/26/97  
CHAIRMAN [Signature]

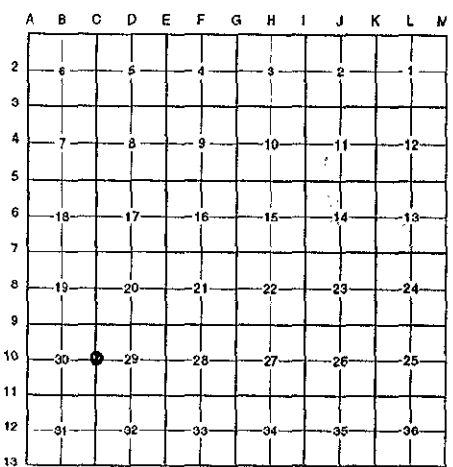

This corner was originally approved by the Kent County Remonumentation Peer Group and monumented by Rob Jonker on 11/13/81 and was recorded per L.C.R.C. #2362.

B. Description of corner evidence found and/or method applied in restoring or reestablishing corner:

C-10 Found a Standard Kent County Monument 8' East of the C/L intersection of Pettis Avenue (bit.) running North and South and Harper Road (gravel) running West on line of a fence line running East per L.C.R.C.'s #2362 and #6282 as set by Rob Jonker in place of a 3/4" crimped iron he found which checked L.C.R.C. #181 and the K.C. Surveyor's records.

L.C.R.C. #2362

L.C.R.C. #6282

Remon. tag on S side 18" Maple S79°W 80.35'  
Remon. tag on NE side 18" Maple N50°W 48.30'  
Remon. tag on N side 40" Hickory S75°E 32.48'  
Remon. tag on W side 36" Cherry N27°E 63.60'  
C/L pavement West 7.5'  
In line fence to East  
On Line C/L gravel to West


Nail & Tag N sd. 44" Hickory S 81 E 32.37' (m. 32.39')  
Nail & Tag W sd. 36" Cherry N 23 E 63.53'  
Nail & Tag NE sd. 22" Maple N 52 W 48.53'  
Nail & Tag S sd. 20" Maple (8' above grd.) S 75 W 80.32' (m. 80.44')  
C/L N-S Bit. West more or less 8'  
On line C/L gravel to west

The selected location is accepted by me and is generally accepted by professional surveyors as the best available evidence of the position of the original corner.

C. Description of monument for corner and accessories established to perpetuate locating the position of the corner:

C-10 Standard Kent County Monument

Nail & K.C. remon. tag on N side 44" Hickory S 81° E 32.39'  
Nail & K.C. remon. tag on W side 36" Cherry N 23° E 63.53'  
Nail & K.C. remon. tag on NE side 22" Maple N 52° W 48.53'  
Nail & K.C. remon. tag on S side 20" Maple (8' above gnd.) S 75° W 80.44'

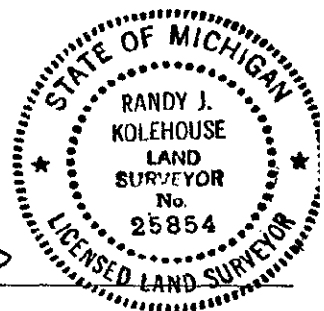

Signed by [Signature] Date 8/12/97

Surveyor's Michigan License No. 25854