

MAR 03 1998

SECTION

LAND CORNER RECORDATION CERTIFICATE
Filing Requirement of Act 74, Mich. P.A. 1970
KENT COUNTY REMONUMENTATION

For corners in

Table with columns: Kent (County), Located in: Cannon Township, Corner Code #. Rows include Public Land Survey, Property Controlling in Section, and Miscellaneous Property in Sec.


STATE OF MICHIGAN
COUNTY OF KENT
RECEIVED FOR RECORD
97 OCT 15 AM 8:44
REG. OF DEEDS

10093

Register of Deeds Stamp & File Number

4. Lot No. , Recorded Plat
5. Private Claims

I, Randy Kolehouse, in a field survey on June 11 19 97, do hereby certify that under requirements of P.A. 74 Michigan P.A. of 1970, the corner points mentioned in lines 1 and 2 above were in conformance with regulations and rules therefore as required in the current manual of survey instructions of the United States Department of the interior, Bureau of Land Management or by a decree of a Court of Law and/or that the corner points mentioned in lines 3, 4 and 5 above were in conformance with the rules of the Michigan Board of Land Surveyors or by a Decree of a Court of Law; established, re-established, monumented, re-monumented, recovered, found as expressed below:

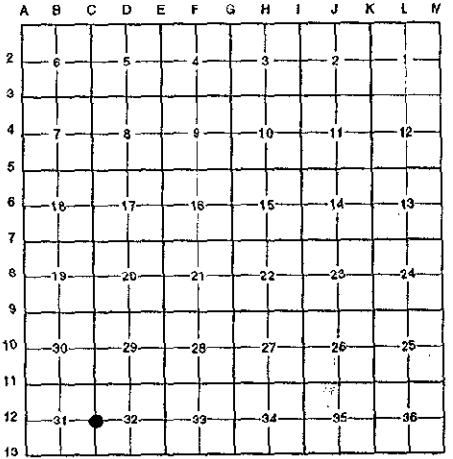

NOTE: Not more than 4 corners, all in the same town and range, may be recorded on this certificate.

A. Description of original monument and accessories and/or subsequent restoration:

Table with 4 columns: Date (C-12 1831, 1937, 1972, 1981, 1991), Description (G.L.O. Notes, Witness Map, L.C.R.C. #450, #2363, #6284), Name (Mullett, K.C. Surveyor, Medema, Van Kooten & Assoc., Jonker Land Surveys, Chris Marschall), and Monument Type (Set Post Stake & Stone, 'T' Iron, Fnd. 'T' Iron / Set K.C. Monument, K.C. Monument).

This corner was originally approved by the Kent County Remonumentation Peer Group and monumented by Rob Jonker on 11/13/81 and was recorded per L.C.R.C. #2363.

B. Description of corner evidence found and/or method applied in restoring or reestablishing corner:

C-12 Found a Standard Kent County Monument 7' East of the C/L of Pettis Avenue (bit.) running North and South on line of a tree row running East and West per L.C.R.C.'s #2363 and #6284 as set by Rob Jonker in place of a 'T' iron he found at grade over a 6" x 8" x 14" pointed stone 18" below grade which checked L.C.R.C. #450 and the K.C. Surveyor's records.

L.C.R.C. #2363

Remon. tag on N side 40" W. Cherry N88°W 103.76'
Remon. tag on W side p. pole S23°E 61.42'
Remon. tag on W side 30" Maple S09°E 91.82'
C/L pavement West 6'
In line E-W tree rows

L.C.R.C. #6284

Nail & Tag S sd. 50" W. Cherry (4' above grd) N 88 W 103.46'
Nail & Tag W sd. P.P. S 26 E 61.36'
Nail & Tag W sd. 36" Maple S 11 E 92.79'
Nail & Tag SE sd. P.P. S 37 W 110.47'
Centerline of Pavement West 6'


The selected location is accepted by me and is generally accepted by professional surveyors as the best available evidence of the position of the original corner.

C. Description of monument for corner and accessories established to perpetuate locating the position of the corner:

C-12 Standard Kent County Monument

Nail & K.C. remon. tag on S side 50" W. Cherry 4' above grd. N 88° W 103.46'
Nail & K.C. remon. tag on W side P. pole S 26° E 61.36'
Nail & K.C. remon. tag on W side 36" Maple S 11° E 92.79'
Nail & K.C. remon. tag on SE side P. pole S 37° W 110.47'

P.A. 345 1990 KENT COUNTY
PEER APPROVED 6/26/97
CHAIRMAN Randy Kolehouse

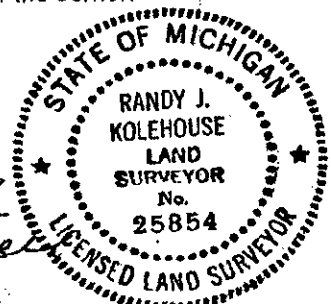

Signed by Randy J. Kolehouse Date 9/12/97
EARTH TECH
Surveyor's Michigan License No. 25854