

**SURVEY & REMONUMENTATION**

**MAR 03 1998**

**SECTION**

**LAND CORNER RECORDATION CERTIFICATE**  
**Filing Requirement of Act 74, Mich. P.A. 1970**  
**KENT COUNTY REMONUMENTATION**

For corners in

Kent  
 (County)

Located in: Cannon  
 Township

Corner Code #

1. Public Land Survey	T <u>8N</u>	R <u>10W</u>	<u>C-13</u>
	T _____	R _____	_____
	T _____	R _____	_____
	T _____	R _____	_____
2. Property Controlling in Section	S _____	T _____	R _____
	S _____	T _____	R _____
3. Miscellaneous Property in Sec.	S _____	T _____	R _____
	S _____	T _____	R _____


4. Lot No. \_\_\_\_\_, Recorded Plat \_\_\_\_\_  
 5. Private Claims \_\_\_\_\_

REG. OF DEEDS  
*Eric J. Bond*  
 97 OCT 15 AM 8:44  
 STATE OF MICHIGAN  
 COUNTY OF KENT  
 RECEIVED FOR RECORD

**10094**

Register of Deeds Stamp & File Number

I, Randy Kolehouse, in a field survey on June 11 19 97, do hereby certify that under requirements of P.A. 74 Michigan P.A. of 1970, the corner points mentioned in lines 1 and 2 above were in conformance with regulations and rules therefore as required in the current manual of survey instructions of the United States Department of the interior, Bureau of Land Management or by a decree of a Court of Law and/or that the corner points mentioned in lines 3, 4 and 5 above were in conformance with the rules of the Michigan Board of Land Surveyors or by a Decree of a Court of Law; established, re-established, monumented, re-monumented, recovered, found as expressed below:

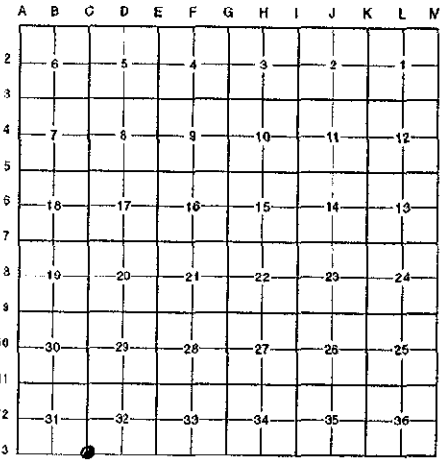

**NOTE: Not more than 4 corners, all in the same town and range, may be recorded on this certificate.**

**A. Description of original monument and accessories and/or subsequent restoration:**

C-13	1831	G.L.O. Notes	Mullett	Set Post
	1937	Witness Map	K.C. Surveyor	Boat Spike & 1" Iron
	1974	L.C.R.C. #778	G. Nederveld	Boat Spike
	1981	L.C.R.C. #1777	Williams & Works	Fnd. Boat Spike in 1" Iron / Set K.C. Monument
	1991	L.C.R.C. #6285	Chris Marschall	K.C. Monument

Note: This corner is not common with C-1, T7N, R10W.

This corner was originally approved by the Kent County Remonumentation Peer Group and monumented by Williams & Works on 1/26/81 and was recorded per L.C.R.C. #1777.

**B. Description of corner evidence found and/or method applied in restoring or reestablishing corner:**

C-13 Found a Standard Kent County Monument 1.5' East and 4' South of the C/L intersection of Pettis Avenue (bit.) running North and South and 4 Mile Road (gravel) running East per L.C.R.C.'s #1777 and #6285 as set by Williams & Works in place of a boat spike in a 1" x 24" iron they found which checked L.C.R.C. #778 and the K.C. Surveyor's records.

L.C.R.C. #1777

L.C.R.C. #6285

Nail and K.C. Remon. Tag SW Side 35" Oak N 45°W 40.56'  
 Nail and K.C. Remon. Tag South Side 26" Walnut S 70°E 97.45'  
 SW Cor. Hse. #5621 Fnd. N 40°E 133.19'  
 NE Cor. Bldg. S 55°E 90.32'  
 SW Cor. Bldg. S 30°E 84.71'  
 SE Cor. Brick Bldg. (No Hse. #) S 45°W 144.80'  
 NW Cor. Brick Pillar West 34.42'  
 On C/L Pettis Rd. N-S, C/L 4 Mile Rd. East

Nail & Tag SW sd. 36" Oak N 45 W 40.32'  
 Nail & Tag S sd. 28" Walnut S 70 E 97.14'  
 NW Cor. Brick Pillar S 85 W 34.42'  
 SE Cor. Brick Bldg. Hse. #3575 S 45 W 144.65'  
 NE Cor. Bldg. S 55 E 90.25'  
 SW Cor. Bldg (Westerly Most Corner) S 30 E 84.68'  
 SW Cor. (Fnd.) Hse #5621 (Westerly Most Corner) N 40 E 133.19'  
 1/4 Cor. C-1 Ada West 303.41'


The selected location is accepted by me and is generally accepted by professional surveyors as the best available evidence of the position of the original corner.

**C. Description of monument for corner and accessories established to perpetuate locating the position of the corner:**

C-13 Standard Kent County Monument  
 Nail & K.C. remon. tag on S side 36" Oak N 45° W 40.32'  
 Nail & K.C. remon. tag on S side 28" Walnut S 70° E 97.14'  
 NW cor. brick pillar S 85° W 34.42'  
 SW cor. bldg. (W'y msot cor.) S 30° E 84.68'  
 K.C. Mon. C-1, T7N, R10W, West 303.41'

P.A. 345 1990 KENT COUNTY

PEER APPROVED 6/26/97  
 CHAIRMAN Fanny Huber

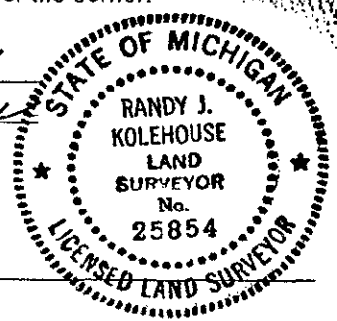

Signed by Randy J. Kolehouse  
 EARTH TECH

Date 8/12/97

Surveyor's Michigan License No. 25854