

**SURVEY & REMONUMENTATION**

**\$7.00** MAR 03 1998  
**\$2.00**

**SECTION**

**LAND CORNER RECORDATION CERTIFICATE**  
**Filing Requirement of Act 74, Mich. P.A. 1970**  
**KENT COUNTY REMONUMENTATION**

STATE OF MICHIGAN  
COUNTY OF KENT  
RECEIVED FOR RECORD  
97 NOV 14 AM 9:01  
REG. OF DEEDS  
*Eric J. Sand*

For corners in


Kent (County)	Located in: Cannon Township	Corner Code #
1. Public Land Survey	T <u>8N</u> R <u>10W</u>	<u>D-1</u>
	T _____ R _____	_____
	T _____ R _____	_____
	T _____ R _____	_____
2. Property Controlling in Section	S _____ T _____ R _____	_____
	S _____ T _____ R _____	_____
3. Miscellaneous Property in Sec.	S _____ T _____ R _____	_____
	S _____ T _____ R _____	_____

**10331**

Register of Deeds Stamp & File Number

4. Lot No. \_\_\_\_\_, Recorded Plat \_\_\_\_\_  
5. Private Claims \_\_\_\_\_

I, Randy Kolehouse, in a field survey on July 15 19 97, do hereby certify that under requirements of P.A. 74 Michigan P.A. of 1970, the corner points mentioned in lines 1 and 2 above were in conformance with regulations and rules therefore as required in the current manual of survey instructions of the United States Department of the Interior, Bureau of Land Management or by a decree of a Court of Law and/or that the corner points mentioned in lines 3, 4 and 5 above were in conformance with the rules of the Michigan Board of Land Surveyors or by a Decree of a Court of Law; established, re-established, monumented, re-monumented, recovered, found as expressed below:

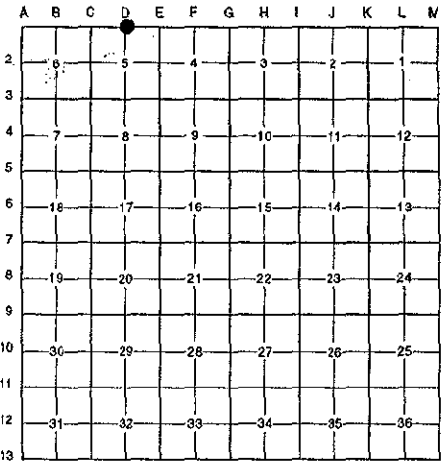

**NOTE: Not more than 4 corners, all in the same town and range, may be recorded on this certificate.**

A. Description of original monument and accessories and/or subsequent restoration:

D-1	This corner was not originally set by the G.L.O.			
N/A	Witness Map	K.C. Surveyor	Iron	
1975	L.C.R.C. #823	Moore & Bruggink	Monument Box	
1984	L.C.R.C. #3979	William Byl	Fnd. 1" Iron Pipe / Set K.C. Monument	
1988	L.C.R.C. #4841	J. Bueche	K.C. Monument	

P.A. 345 1990 KENT COUNTY

PEER APPROVED 8/28/97  
CHAIRMAN Harry Huber

Note: This corner is not common with D-13, T9N, R10W.

This corner was originally approved by the Kent County Remonumentation Peer Group and monumented by William Byl on 6/3/88 and was recorded per L.C.R.C. #4841.

B. Description of corner evidence found and/or method applied in restoring or reestablishing corner:

D-1 Found a Standard Kent County Monument on the Township line 700' South of the C/L of 10 Mile Road (bit.) running East and West and 165' ± East of a tree row running North per L.C.R.C.'s #3979 and #4841 as set by William Byl in place of a 1" iron pipe he found approximately 1.4' East of being midway between the NE & NW corners of Section 5 and 6.8' North of the South line of Section 32 which checked L.C.R.C. #823 and the K.C. Surveyor's records.

L.C.R.C. #3979

L.C.R.C. #4841

Nail & tag, W sd. 12" Oak N 05 E 28.50'  
Nail & tag, N sd. 24" Oak N 80 W 25.72'  
Nail & tag, E sd. 12" Oak S 05 E 11.48'  
Nail & tag, S sd. 15" Maple N 80 E 48.42'  
Iron pipe N 00 W 6.79'

Nail & tag W sde 14" Oak N 5 E 28.50'  
Nail & tag N sde 26" Oak N 80 W 26.72'  
Nail & tag E sde 14" Oak S 5 E 11.48'  
Nail & tag S sde 17" Maple N 80 E 48.42'  
Iron pipe N 0 W 6.79'

Kent Co. Monument (S 1/4 cor. Sec. 32, T9N, R10W) N 90 W 163.66'


K.C. Mon (S 1/4 cor sec 32, T9N, R10W) N 90 W 163.66'

The selected location is accepted by me and is generally accepted by professional surveyors as the best available evidence of the position of the original corner.

C. Description of monument for corner and accessories established to perpetuate locating the position of the corner:

D-1 Standard Kent County Monument

Nail & K.C. remon. tag on W side 14" Oak N 05° E 28.50'  
Nail & K.C. remon. tag on N side 26" Oak N 80° W 26.72'  
Nail & K.C. remon. tag on E side 14" Oak S 05° E 11.48'  
Nail & K.C. remon. tag on S side 18" Maple N 80° E 48.42'  
K.C. Mon., S 1/4 cor. Section 32, T9N, R10W, N 90° W 163.66'

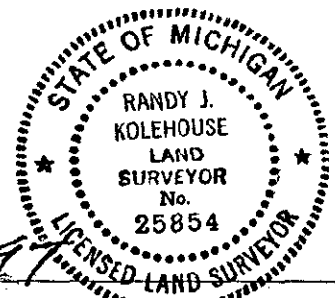

Signed by Randy J. Kolehouse Date 9/23/97  
EARTH TECH

Surveyor's Michigan License No. 25854