

SURVEY & REMONUMENTATION

MAR 03 1998

SECTION

LAND CORNER RECORDATION CERTIFICATE
Filing Requirement of Act 74, Mich. P.A. 1970
KENT COUNTY REMONUMENTATION

For corners in

Kent (County)	Located in: Cannon Township	Corner Code #
1. Public Land Survey	T <u>8N</u> R <u>10W</u>	<u>D-3</u>
	T _____ R _____	_____
	T _____ R _____	_____
	T _____ R _____	_____
2. Property Controlling in Section	S _____ T _____ R _____	_____
	S _____ T _____ R _____	_____
3. Miscellaneous Property in Sec.	S _____ T _____ R _____	_____
	S _____ T _____ R _____	_____
4. Lot No. _____, Recorded Plat _____		
5. Private Claims _____		

STATE OF MICHIGAN
 COUNTY OF KENT
 RECEIVED FOR RECORD
 97 OCT 15 AM 8:44
 REG. OF DEEDS
Lucy Standa

10095


Register of Deeds Stamp & File Number

I, Randy Kolehouse, in a field survey on June 12 19 97, do hereby certify that under requirements of P.A. 74 Michigan P.A. of 1970, the corner points mentioned in lines 1 and 2 above were in conformance with regulations and rules therefore as required in the current manual of survey instructions of the United States Department of the interior, Bureau of Land Management or by a decree of a Court of Law and/or that the corner points mentioned in lines 3, 4 and 5 above were in conformance with the rules of the Michigan Board of Land Surveyors or by a Decree of a Court of Law; established, re-established, monumented, re-monumented, recovered, found as expressed below:

NOTE: Not more than 4 corners, all in the same town and range, may be recorded on this certificate.

A. Description of original monument and accessories and/or subsequent restoration:

D-3	1831	G.L.O. Notes	Mullett	Set Post
	N/A	Witness Map	K.C. Surveyor	Iron
	1975	L.C.R.C. #823	Moore & Bruggink	Wagon Spring
	1975	L.C.R.C. #875	Medema, Van Kooten & Assoc.	Square Spike
	1981	L.C.R.C. #2364	Jonker Land Surveys	Fnd. Square Spike / Set K.C. Monument
	1991	L.C.R.C. #6286	Chris Marschall	K.C. Monument

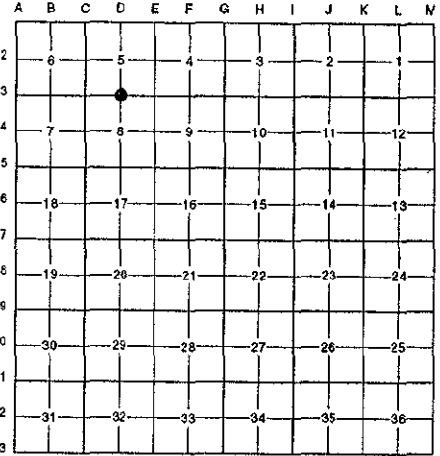

This corner was originally approved by the Kent County Remonumentation Peer Group and monumented by Rob Jonker on 11/10/81 and was recorded per L.C.R.C. #2364.

B. Description of corner evidence found and/or method applied in restoring or reestablishing corner:

D-3 Found a Standard Kent County Monument on the C/L of 9 Mile Road (bit.) running East and West on line of a tree row running North and South per L.C.R.C.'s #2364 and #6286 as set by Rob Jonker in place of a square spike he found which checked L.C.R.C.'s #875, #823 and the K.C. Surveyor's records.

L.C.R.C. #2364

L.C.R.C. #6286

Remon. tag on E side tr. 15" Oak S19°W 26.48'	Nail & Tag E sd. Tri. 18" Oak S 19° W 26.41'
Remon. tag on E side t. pole N10°W 39.90'	Nail & Tag E sd. P.P. S 01° E 33.77'
Remon. tag on N side 34" Pine S74°E 133.26'	Nail & Tag N sd. P.P. S 70° E 104.08'
On C/L E-W pavement	On C/L E. W. Pavement


The selected location is accepted by me and is generally accepted by professional surveyors as the best available evidence of the position of the original corner.

C. Description of monument for corner and accessories established to perpetuate locating the position of the corner:

D-3 Standard Kent County Monument

Nail & K.C. remon. tag on E side Tri. 18" Oak S 19° W 26.41'
 Nail & K.C. remon. tag on E side P.P. S 01° E 33.77'
 Nail & K.C. remon. tag on E side T.P. N 10° W 39.88'
 Nail & K.C. remon. tag on N side P.P. S 70° E 104.08'

P.A. 345 1990 KENT COUNTY
 PEER APPROVED 6/26/97
 CHAIRMAN *Harry Hubert*

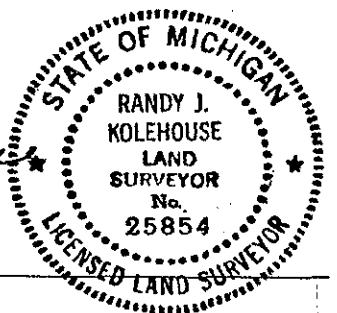

Signed by *Randy J. Kolehouse*
 EARTH TECH

Date 8/12/97

Surveyor's Michigan License No. 25854