

SURVEY & REMONUMENTATION

MAR 03 1998

SECTION

LAND CORNER RECORDATION CERTIFICATE
Filing Requirement of Act 74, Mich. P.A. 1970
KENT COUNTY REMONUMENTATION

For corners in

Kent (County)	Located in: Cannon Township	Corner Code #
1. Public Land Survey	T <u>8N</u> R <u>10W</u>	<u>D-5</u>
	T _____ R _____	_____
	T _____ R _____	_____
	T _____ R _____	_____
2. Property Controlling in Section	S _____ T _____ R _____	_____
	S _____ T _____ R _____	_____
3. Miscellaneous Property in Sec.	S _____ T _____ R _____	_____
	S _____ T _____ R _____	_____

REG. OF DEEDS

W. J. K. [Signature]

97 OCT 15 AM 8:44


STATE OF MICHIGAN
 COUNTY OF KENT
 RECEIVED FOR RECORD

10096

Register of Deeds Stamp & File Number

4. Lot No. _____, Recorded Plat _____
 5. Private Claims _____

I, Randy Kolehouse, in a field survey on June 12 19 97, do hereby certify that under requirements of P.A. 74 Michigan P.A. of 1970, the corner points mentioned in lines 1 and 2 above were in conformance with regulations and rules therefore as required in the current manual of survey instructions of the United States Department of the interior, Bureau of Land Management or by a decree of a Court of Law and/or that the corner points mentioned in lines 3, 4 and 5 above were in conformance with the rules of the Michigan Board of Land Surveyors or by a Decree of a Court of Law; established, re-established, monumented, re-monumented, recovered, found as expressed below:

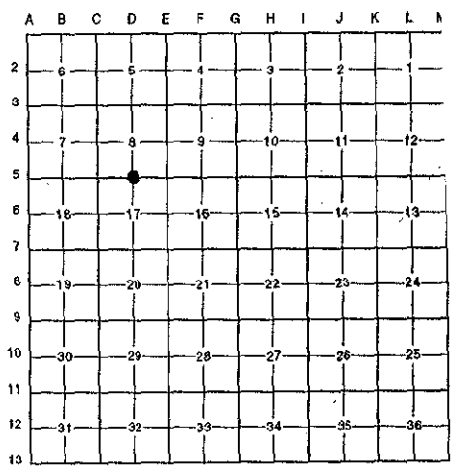

NOTE: Not more than 4 corners, all in the same town and range, may be recorded on this certificate.

A. Description of original monument and accessories and/or subsequent restoration:

D-5	1831	G.L.O. Notes	Mullett	Set Post
	1930	Witness Map	K.C. Surveyor	Iron
	1974	L.C.R.C. #777	Nederveld & Jonker	Iron in Monument Box
	1980	L.C.R.C. #1465	Williams & Works	End. 1" Iron in Mon. Box / Set K.C. Monument
	1992	L.C.R.C. #6287	Chris Marschall	K.C. Monument P.A. 345 1990 KENT COUNTY

PEER APPROVED 6/26/97
 CHAIRMAN Harry Huber


This corner was originally approved by the Kent County Remonumentation Peer Group and monumented by Williams & Works on 10/30/80 and was recorded per L.C.R.C. #1465.

B. Description of corner evidence found and/or method applied in restoring or reestablishing corner:
 D-5 Found a Standard Kent County Monument on 2.5' ± North of the C/L of Belding Road (bit.) running East and West per L.C.R.C.'s #1465 and #6287 as set by Williams & Works in place of a 1" iron they found in a monument box which checked L.C.R.C. #777 and the K.C. Surveyor's records.

L.C.R.C. #1465	L.C.R.C. #6287
Nail & K.C. Remon. Tag North Side Power Pole S 55°W 81.81'	Nail & Tag W sd. U.P. S 49 W 81.83'
Nail & K.C. Remon. Tag SW Side MBT & Light Pole N 60°W 85.01'	Nail & Tag W sd. 12" Apple S 43 E 107.30'
Nail & K.C. Remon. Tag West Side 10" Dbl Elm N 45°E 106.65'	Nail & Tag W sd. U.P. N 64 E 94.82'
	Nail & Tag SW sd. U.P. N 61 W 85.04'

The selected location is accepted by me and is generally accepted by professional surveyors as the best available evidence of the position of the original corner.

C. Description of monument for corner and accessories established to perpetuate locating the position of the corner:
 D-5 Standard Kent County Monument
 Nail & K.C. remon. tag on W side Util. pole S 49° W 81.83'
 Nail & K.C. remon. tag on W side 12" Apple S 43° E 107.30'
 Nail & K.C. remon. tag on W side Util. pole N 64° E 94.82'
 Nail & K.C. remon. tag on SW side Util. pole N 61° W 85.04'
 Nail & K.C. remon. tag on E side 6' x 8" post South 52.72'

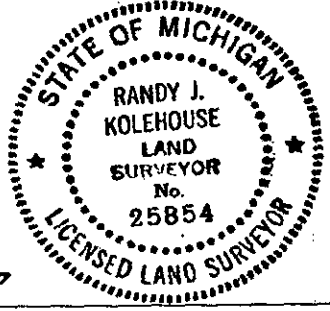

Signed by Randy J. Kolehouse Date 8/12/97
 EARTH TECH
 Surveyor's Michigan License No. 25854