

SURVEY & REMONUMENTATION

\$7.00
\$2.00
MAR 03 1998

SECTION

LAND CORNER RECORDATION CERTIFICATE
Filing Requirement of Act 74, Mich. P.A. 1970
KENT COUNTY REMONUMENTATION

For corners in:

<u>Kent</u> (County)	Located in: Cannon Township	Corner Code #
1. Public Land Survey	T <u>8N</u> R <u>10W</u>	<u>D-7</u>
	T _____ R _____	_____
	T _____ R _____	_____
	T _____ R _____	_____
2. Property Controlling in Section	S _____ T _____ R _____	_____
	S _____ T _____ R _____	_____
3. Miscellaneous Property in Sec.	S _____ T _____ R _____	_____
	S _____ T _____ R _____	_____


STATE OF MICHIGAN
COUNTY OF KENT
RECEIVED FOR RECORD
97 DEC 15 AM 10:43
REG. OF DEEDS
David J. ...

10391

Register of Deeds Stamp & File Number

4. Lot No. _____, Recorded Plat _____
5. Private Claims _____

I, Randy Kolehouse, in a field survey on February 17 19 97, do hereby certify that under requirements of P.A. 74 Michigan P.A. of 1970, the corner points mentioned in lines 1 and 2 above were in conformance with regulations and rules therefore as required in the current manual of survey instructions of the United States Department of the interior, Bureau of Land Management or by a decree of a Court of Law and/or that the corner points mentioned in lines 3, 4 and 5 above were in conformance with the rules of the Michigan Board of Land Surveyors or by a Decree of a Court of Law; established, re-established, monumented, re-monumented, recovered, found as expressed below:

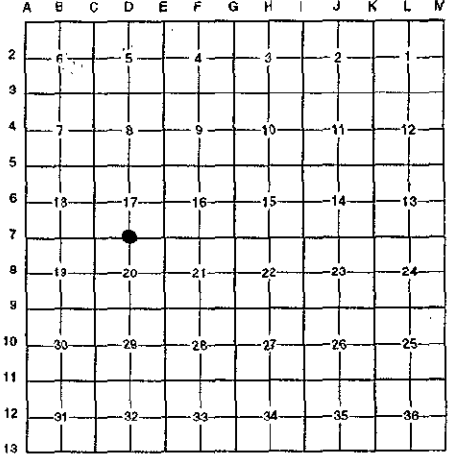

NOTE: Not more than 4 corners, all in the same town and range, may be recorded on this certificate.

A. Description of original monument and accessories and/or subsequent restoration:

D-7	1831	G.L.O. Notes	Mullett	Set Post
	N/A	Witness Map	K.C. Surveyor	Iron & Stones
	1964	Notes	Williams & Works	Iron & Stones
	1968	Notes	Williams & Works	N/A
	1981	L.C.R.C. #3563	Medema, Van Kooten & Assoc.	"T" Iron
	1987	L.C.R.C. #4486	All-Points Surveyors, Inc.	Fnd. "T" Iron / Set K.C. Monument
	1991	L.C.R.C. #6288	Chris Marschall	K.C. Monument

P.A. 345 1990 KENT COUNTY
PEER APPROVED 6/26/97
CHAIRMAN *Henry Shuber*

This corner was originally approved by the Kent County Remonumentation Peer Group and monumented by All-Points Surveyors in January of 87 and was recorded per L.C.R.C. #4486.


B. Description of corner evidence found and/or method applied in restoring or reestablishing corner:

- D-7 Seven Mile Road has been rebuilt and the K.C. Monument destroyed. Set a P.K. nail in a cul-de-sac at the East end of 7 Mile Road using the witnesses indicated below.
- | | |
|---|---|
| L.C.R.C. #4486 | L.C.R.C. #6288 |
| Nail & K.C. Remon. Tag W. side 24" Oak S 03° E 92.58' | Nail & Tag W sd. 24" Oak (3' above grd.) S 03° E 92.52' (m. 92.58') |
| | Nail & Tag E sd. 10" Oak S 08° W 84.10' |

The selected location is accepted by me and is generally accepted by professional surveyors as the best available evidence of the position of the original corner.

C. Description of monument for corner and accessories established to perpetuate locating the position of the corner:

- D-7 Replaced P.K. Nail with a Standard Kent County Monument
- Nail & K.C. remon. tag on W side 6" x 6" guard post N 53° E 56.04'
 - Nail & K.C. remon. tag on W side 24" Oak 3' above gnd. S 03° E 92.58'
 - Nail & K.C. remon. tag on E side 10" Oak S 08° W 84.21'
 - Nail & K.C. remon. tag on W side 14" Aspen 4' above gnd. N 25° W 75.41'
 - C/L bit. road West is 3' ± South of corner

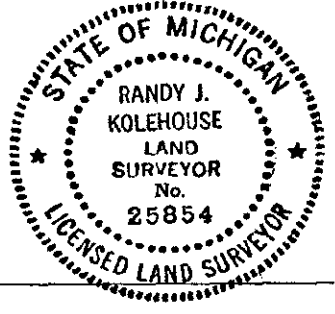

Signed by *Randy J. Kolehouse* Date 12/5/97
EARTH TECH

Surveyor's Michigan License No. 25854