

SURVEY & REMONUMENTATION

MAR 03 1998

\$7.00
\$2.00

SECTION LAND CORNER RECORDATION CERTIFICATE

Filing Requirement of Act 74, Mich. P.A. 1970

KENT COUNTY REMONUMENTATION

For corners in

Kent (County)	Located in:	Cannon Township	Corner Code #
1. Public Land Survey	T <u>8N</u>	R <u>10W</u>	<u>D-10</u>
	T _____	R _____	_____
	T _____	R _____	_____
	T _____	R _____	_____
2. Property Controlling in Section	S _____	T _____	R _____
	S _____	T _____	R _____
3. Miscellaneous Property in Sec.	S _____	T _____	R _____
	S _____	T _____	R _____

97 DEC 15 AM 10:43
 STATE OF MICHIGAN
 COUNTY OF KENT
 RECEIVED FOR RECORD
 REG. OF DEEDS
David Bond

10393

Register of Deeds Stamp & File Number

4. Lot No. _____, Recorded Plat _____
 5. Private Claims _____


I, Randy Kolehouse, in a field survey on October 10 19 97, do hereby certify that under requirements of P.A. 74 Michigan P.A. of 1970, the corner points mentioned in lines 1 and 2 above were in conformance with regulations and rules therefore as required in the current manual of survey instructions of the United States Department of the interior, Bureau of Land Management or by a decree of a Court of Law and/or that the corner points mentioned in lines 3, 4 and 5 above were in conformance with the rules of the Michigan Board of Land Surveyors or by a Decree of a Court of Law; established, re-established, monumented, re-monumented, recovered, found as expressed below:

NOTE: Not more than 4 corners, all in the same town and range, may be recorded on this certificate.

A. Description of original monument and accessories and/or subsequent restoration:

D-10 This corner was not originally set by the G.L.O.

N/A	Witness Map	K.C. Surveyor	Plow Point
1981	L.C.R.C. #2095	Medema, Van Kooten & Assoc.	Plow Point / Set 3/4" Iron

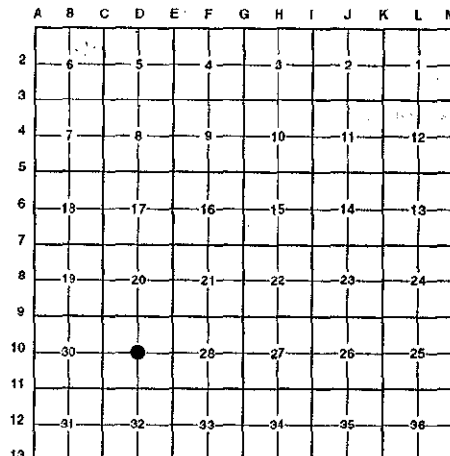

P.A. 345 1990 KENT COUNTY,
 PEER APPROVED 10/30/97
 CHAIRMAN *[Signature]*

B. Description of corner evidence found and/or method applied in restoring or reestablishing corner:

D-10 Found a 1/2" rebar on line of a fence line running North and 10' ± South of a fence line running West that checks witnesses from L.C.R.C. #2095 and also checks closely to one remaining witness and a 3/4" iron set alongside a plow point shown on the K.C. Witness Map. Area has been filled and the 3/4" iron and plow point either buried or removed. Rebar is 0.07' North and 0.04' West of the intersection of 1/4 lines. Accepted rebar as Center of Section.

K.C. Witness Map	L.C.R.C. #2095
10" Oak NW 27'	Sq. spike in W side 12" Oak S-SE 18.04' (m. 17.98")
	Sq. spike in SE side 12" Oak SW 49.79' (m. 49.74")
	Sq. spike in E'ly side 12" Oak NW 27.75' (m. 27.76")
	Sq. spike in E side 12" Oak N 13.03' (m. 13.02")

The selected location is accepted by me and is generally accepted by professional surveyors as the best available evidence of the position of the original corner.

C. Description of monument for corner and accessories established to perpetuate locating the position of the corner:

D-10 Replaced Rebar with a Standard Kent County Monument

Nail & K.C. remon. tag on West side 14' Oak S 15° E 17.98'
 Nail & K.C. remon. tag on SE side 12' Oak S 20° W 49.74'
 Nail & K.C. remon. tag on NE side 12' Oak N 10° W 27.76'
 Nail & K.C. remon. tag on East side 12' Oak North 13.02'

Signed by *Randy J. Kolehouse*
 EARTH TECH

Date 11/28/97

Surveyor's Michigan License No. 25854

