

SURVEY & REMONUMENTATION

\$7.00
\$2.00

MAR 03 1998

LAND CORNER RECORDATION CERTIFICATE
Filing Requirement of Act 74, Mich. P.A. 1970
KENT COUNTY REMONUMENTATION

STATE OF MICHIGAN
COUNTY OF KENT
RECEIVED FOR RECORD
97 DEC 15 AM 10:44
REG. OF DEEDS
Lucy Bond


For corners in SECTION

Kent (County)	Located in:	Cannon Township	Corner Code #
1. Public Land Survey	T <u>8N</u>	R <u>10W</u>	<u>E-2</u>
	T _____	R _____	_____
	T _____	R _____	_____
	T _____	R _____	_____
2. Property Controlling in Section	S _____	T _____	R _____
	S _____	T _____	R _____
3. Miscellaneous Property in Sec.	S _____	T _____	R _____
	S _____	T _____	R _____

10396
Register of Deeds Stamp & File Number

4. Lot No. _____, Recorded Plat _____
5. Private Claims _____

I, Randy Kolehouse, in a field survey on August 16 19 97, do hereby certify that under requirements of P.A. 74 Michigan P.A. of 1970, the corner points mentioned in lines 1 and 2 above were in conformance with regulations and rules therefore as required in the current manual of survey instructions of the United States Department of the Interior, Bureau of Land Management or by a decree of a Court of Law and/or that the corner points mentioned in lines 3, 4 and 5 above were in conformance with the rules of the Michigan Board of Land Surveyors or by a Decree of a Court of Law; established, re-established, monumented, re-monumented, recovered, found as expressed below:

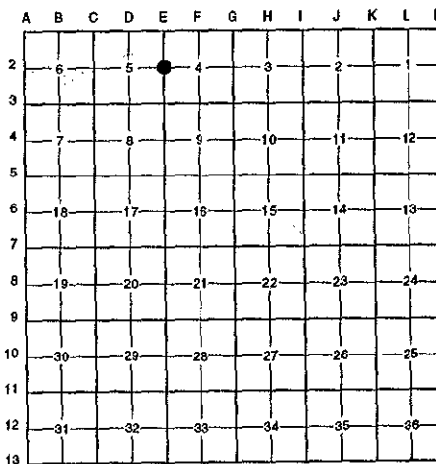

NOTE: Not more than 4 corners, all in the same town and range, may be recorded on this certificate.

A. Description of original monument and accessories and/or subsequent restoration:

E-2	1831	G.L.O. Notes	Mullett	Set Post
	1961	Witness Map	K.C. Surveyor	Iron
	1974	L.C.R.C. #688	Exxel Engineering	3/4" Iron
	1981	L.C.R.C. #2367	Jonker Land Surveys	Fnd. 3/4" Iron / Set K.C. Monument
	1991	L.C.R.C. #6292	Chris Marschall	K.C. Monument

P.A. 345 1990 KENT COUNTY
PEER APPROVED 11/20/97

CHAIRMAN [Signature]

This corner was originally approved by the Kent County Remonumentation Peer Group and monumented by Rob Jonker on 11/17/81 and was recorded per L.C.R.C. #2367.

B. Description of corner evidence found and/or method applied in restoring or reestablishing corner:

E-2 Found a Standard Kent County Monument on line of a tree row running North and South, 250' South of power lines running East and West, and on line of fence lines running North, South and West per L.C.R.C.'s #2367 and #6292 as set by Rob Jonker in place of a 3/4" iron he found which checked L.C.R.C. #688 and the K.C. Surveyor's records.

L.C.R.C. #2367

Remon. tag on face of 36" Oak Westerly 0.6'
Remon. tag on W side of 18" W. Cherry S 18° W 14.55'
Remon. tag on SE side of 10" Oak S 73° W 53.8'
Remon. tag on W side of 6" Elm N 32° E 11.75'
Fence line to N, S, W

L.C.R.C. #6292


Nail & Tag W sd. 28" W. Cherry S 18° W 14.55'
Nail & Tag E sd. 10" Elm N 25° E 11.72'
Nail & Tag W sd. 6" Cherry (3' above grd.) N05° E 27.17'

The selected location is accepted by me and is generally accepted by professional surveyors as the best available evidence of the position of the original corner.

C. Description of monument for corner and accessories established to perpetuate locating the position of the corner:

E-2 Standard Kent County Monument

Nail & K.C. remon. tag on E face 36" Oak N 90° W 0.62'
Nail & K.C. remon. tag on W face 18" W. Cherry S 18° W 14.55'
Nail & K.C. remon. tag on SE face 10" Oak S 73° W 53.95'
Nail & K.C. remon. tag on E face 10" Elm N 25° E 11.72'
Nail & K.C. remon. tag on W face 6" Cherry N 05° E 27.17'

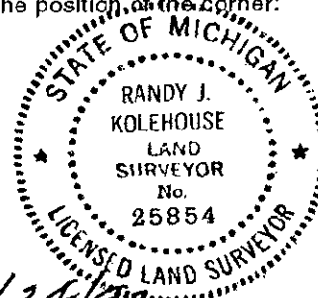

Signed by [Signature] Date 11/24/97

EARTH TECH

Surveyor's Michigan License No. 25854