

SURVEY & REMONUMENTATION

MAR 03 1998

\$7.00
\$2.00

SECTION

LAND CORNER RECORDATION CERTIFICATE

Filing Requirement of Act 74, Mich. P.A. 1970

KENT COUNTY REMONUMENTATION

For corners in

Kent (County)	Located in: Cannon Township	Corner Code #
1. Public Land Survey	T <u>8N</u> R <u>10W</u>	<u>E-3</u>
	T _____ R _____	_____
	T _____ R _____	_____
	T _____ R _____	_____
2. Property Controlling in Section	S _____ T _____ R _____	_____
	S _____ T _____ R _____	_____
3. Miscellaneous Property in Sec.	S _____ T _____ R _____	_____
	S _____ T _____ R _____	_____


STATE OF MICHIGAN
COUNTY OF KENT
RECEIVED FOR RECORD
97 DEC 15 AM 10:44
REG. OF DEEDS
Luci Stand

10397

Register of Deeds Stamp & File Number

- 4. Lot No. _____, Recorded Plat _____
- 5. Private Claims _____

I, Randy Kolehouse, in a field survey on August 14 19 97, do hereby certify that under requirements of P.A. 74 Michigan P.A. of 1970, the corner points mentioned in lines 1 and 2 above were in conformance with regulations and rules therefore as required in the current manual of survey instructions of the United States Department of the interior, Bureau of Land Management or by a decree of a Court of Law and/or that the corner points mentioned in lines 3, 4 and 5 above were in conformance with the rules of the Michigan Board of Land Surveyors or by a Decree of a Court of Law; established, re-established, monumented, re-monumented, recovered, found as expressed below:

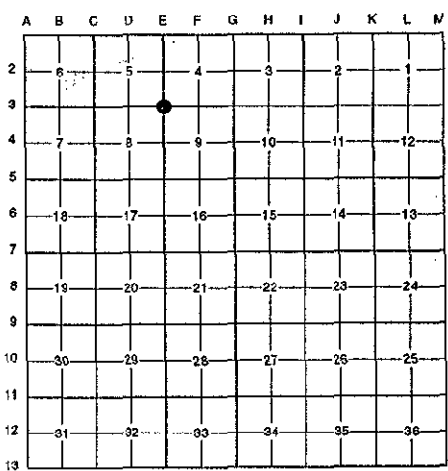

NOTE: Not more than 4 corners, all in the same town and range, may be recorded on this certificate.

A. Description of original monument and accessories and/or subsequent restoration:

E-3	1831	G.L.O. Notes	Mullett	Set Post
	N/A	Witness Map	K.C. Surveyor	Iron
	1973	L.C.R.C. #495	Williams & Works	Iron
	1981	L.C.R.C. #2368	Jonker Land Surveys	Fnd. 1" Iron / Set K.C. Monument
	1991	L.C.R.C. #6293	Chris Marschall	K.C. Monument

P.A. 345 1990 KENT COUNTY
PEER APPROVED 11/20/97
CHAIRMAN [Signature]

This corner was originally approved by the Kent County Remonumentation Peer Group and monumented by Rob Jonker on 11/10/81 and was recorded per L.C.R.C. #2368.

B. Description of corner evidence found and/or method applied in restoring or reestablishing corner:

E-3 Found a Standard Kent County Monument on line of a fence line running West and North and 200' + North of the C/L of 9 Mile Road (bit.) running East and West per L.C.R.C.'s #2368 and #6293 as set by Rob Jonker in place of a 1" iron he found in a circle of small stones which checked L.C.R.C. #495 and the K.C. Surveyor's records.

L.C.R.C. #2368

- Remon. tag on W side 34° Oak N 03° E 13.01'
- Remon. tag on S side 14" Hickory S 76° W 16.98'
- Remon. tag on E side 9" Maple S 26° W 7.18'
- Remon. tag on SE side 4" Maple N 37° E 3.20'

L.C.R.C. #6293


- Remon. tag on W side 34° Oak N 03° E 13.01' (m. 13.04')
- Remon. tag on S side 14" Hickory S 76° W 16.98' (m. 16.91')
- Remon. tag on E side 9" Maple S 26° W 7.18' (m. 7.17')
- Remon. tag on SE side 4" Maple N 37° E 3.20' (m. 3.43')

The selected location is accepted by me and is generally accepted by professional surveyors as the best available evidence of the position of the original corner.

C. Description of monument for corner and accessories established to perpetuate locating the position of the corner:

E-3 Standard Kent County Monument

- Nail & K.C. remon. tag on W side 34" Oak N 03° E 13.04'
- Nail & K.C. remon. tag on S side 15 Hickory S 76° W 16.91'
- Nail & K.C. remon. tag on SW side 12" Maple S 26° W 7.17'
- Nail & K.C. remon. tag on SE side 8" Maple N 37° E 3.43'
- Nail & K.C. remon. tag on S side 4" Elm N 50° W 3.78'

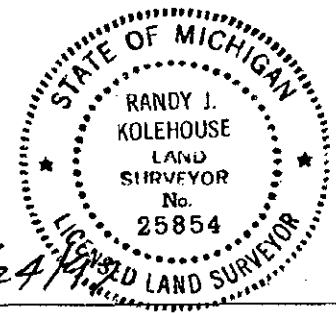

Signed by Randy J. Kolehouse Date 11/24/97
EARTH TECH
Surveyor's Michigan License No. 25854