

**SURVEY & REMONUMENTATION**

**MAR 09 1998**

**LAND CORNER RECORDATION CERTIFICATE  
Filing Requirement of Act 74, Mich. P.A. 1970  
KENT COUNTY REMONUMENTATION**

For corners in **SECTION**

Kent (County)	Located in: Cannon Township	Corner Code #
1. Public Land Survey	T <u>8N</u> R <u>10W</u>	<u>E-5</u>
	T _____ R _____	_____
	T _____ R _____	_____
	T _____ R _____	_____
2. Property Controlling in Section	S _____ T _____ R _____	_____
	S _____ T _____ R _____	_____
3. Miscellaneous Property in Sec.	S _____ T _____ R _____	_____
	S _____ T _____ R _____	_____

STATE OF MICHIGAN  
COUNTY OF KENT  
RECEIVED FOR RECORD  
97 OCT 15 AM 8:44  
REG. OF DEEDS  
*David Bond*

**10099**

Register of Deeds Stamp & File Number


4. Lot No. \_\_\_\_\_, Recorded Plat \_\_\_\_\_  
5. Private Claims \_\_\_\_\_

I, Randy Kolehouse, in a field survey on June 11 19 97, do hereby certify that under requirements of P.A. 74 Michigan P.A. of 1970, the corner points mentioned in lines 1 and 2 above were in conformance with regulations and rules therefore as required in the current manual of survey instructions of the United States Department of the interior, Bureau of Land Management or by a decree of a Court of Law and/or that the corner points mentioned in lines 3, 4 and 5 above were in conformance with the rules of the Michigan Board of Land Surveyors or by a Decree of a Court of Law; established, re-established, monumented, re-monumented, recovered, found as expressed below:

**NOTE: Not more than 4 corners, all in the same town and range, may be recorded on this certificate.**

**A. Description of original monument and accessories and/or subsequent restoration:**

E-5	1831	G.L.O. Notes	Mullett	Set Post	P.A. 345 1990 KENT COUNTY
	1930	Witness Map	K.C. Surveyor	Iron	PEER APPROVED <u>6/26/97</u>
	1971	L.C.R.C. #69	Williams & Works	Monument Box	CHAIRMAN <u>Randy Kolehouse</u>
	1972	L.C.R.C. #395	Williams & Works	1" Iron in Monument Box	
	1981	L.C.R.C. #3563	Medema, Van Kooten & Assoc.	Fnd. Iron in Mon. Box / Reset with 1/2" Capped Iron	
	1981	L.C.R.C. #2369	Jonker Land Surveys	Fnd. Capped Iron in Mon. Box / Set K.C. Monument in Mon. Box	
	1992	L.C.R.C. #6294	Chris Marschall	K.C. Monument	

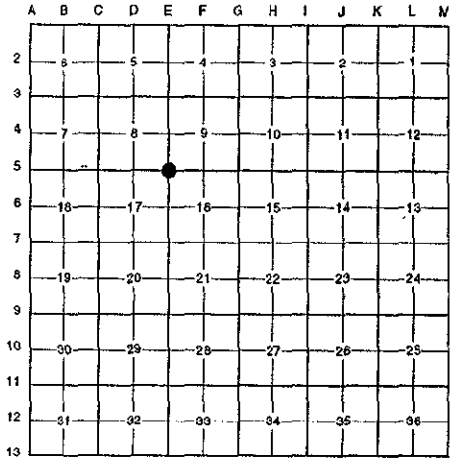

This corner was originally approved by the Kent County Remonumentation Peer Group and monumented by Rob Jonker on 11/11/81 and was recorded per L.C.R.C. #2369.

**B. Description of corner evidence found and/or method applied in restoring or reestablishing corner:**

E-5 Found a Standard Kent County Monument 5' South of the C/L intersection of Egypt Valley Avenue (bit.) running South and Belding Road (bit.) running East and West on line of a tree row running North per L.C.R.C.'s #2369 and #6294 as set by Rob Jonker in place of a capped iron he found in a monument box over a 1" iron 14" below grade which checked L.C.R.C.'s #3563, #395, #69 and the K.C. Surveyor's records.

L.C.R.C. #2369

L.C.R.C. #6294

Remon. tag on NE side p. pole S40°E 73.67'	Nail & Tag W sd. U.P. N 01° W 48.55'
Remon. tag on E side t. pole N05°E 49.18'	Nail & Tag NE sd. U.P. N 70° W 138.87' (m. 138.95')
Remon. tag on NE side t. pole N66°W 139.00'	Nail & Tag E sd. 24" Cottonwood S 13° W 114.70'
P.K. nail on curb joint S42°W 41.11'	Nail & Tag NE sd. U.P. S 45° E 73.69'
C/L traveled way N 5.1' m/l	C/L Bit. E-W, N more or less 5.00'

The selected location is accepted by me and is generally accepted by professional surveyors as the best available evidence of the position of the original corner.

**C. Description of monument for corner and accessories established to perpetuate locating the position of the corner:**

E-5 Standard Kent County Monument  
 Nail & K.C. remon. tag on W side Util. pole N 01° W 48.55'  
 Nail & K.C. remon. tag on NE side Util. pole N 70° W 138.95'  
 Nail & K.C. remon. tag on E side 24" Cottonwood S 13° W 114.70'  
 Nail & K.C. remon. tag on NE side Util. pole S 45° E 73.69'



Signed by Randy J. Kolehouse Date 8/12/97  
EARTH TECH

Surveyor's Michigan License No. 25854