

MAR 03 1998

SECTION

LAND CORNER RECORDATION CERTIFICATE
Filing Requirement of Act 74, Mich. P.A. 1970
KENT COUNTY REMONUMENTATION

For corners in

Kent (County)	Located in: Cannon Township	Corner Code #
1. Public Land Survey	T <u>8N</u> R <u>10W</u>	<u>E-7</u>
	T _____ R _____	_____
	T _____ R _____	_____
	T _____ R _____	_____
2. Property Controlling in Section	S _____ T _____ R _____	_____
	S _____ T _____ R _____	_____
3. Miscellaneous Property in Sec.	S _____ T _____ R _____	_____
	S _____ T _____ R _____	_____

REG. OF DEEDS

Lucy Standa

97 OCT 15 AM 8:45

STATE OF MICHIGAN
 COUNTY OF KENT
 RECEIVED FOR RECORD

10101

Register of Deeds Stamp & File Number


- 4. Lot No. _____, Recorded Plat _____
- 5. Private Claims _____

I, Randy Kolehouse, in a field survey on June 11 19 97, do hereby certify that under requirements of P.A. 74 Michigan P.A. of 1970, the corner points mentioned in lines 1 and 2 above were in conformance with regulations and rules therefore as required in the current manual of survey instructions of the United States Department of the Interior, Bureau of Land Management or by a decree of a Court of Law and/or that the corner points mentioned in lines 3, 4 and 5 above were in conformance with the rules of the Michigan Board of Land Surveyors or by a Decree of a Court of Law; established, re-established, monumented, re-monumented, recovered, found as expressed below:

NOTE: Not more than 4 corners, all in the same town and range, may be recorded on this certificate.

A. Description of original monument and accessories and/or subsequent restoration:

E-7	1831	G.L.O. Notes	Mullett	Set Post
	N/A	Witness Map	K.C. Surveyor	Iron
	1979	L.C.R.C. #1251	Williams & Works	1" Iron
	1981	L.C.R.C. #2371	Jonker Land Surveys	Fnd. 1" Iron / Set K.C. Monument
	1991	L.C.R.C. #6296	Chris Marschall	K.C. Monument

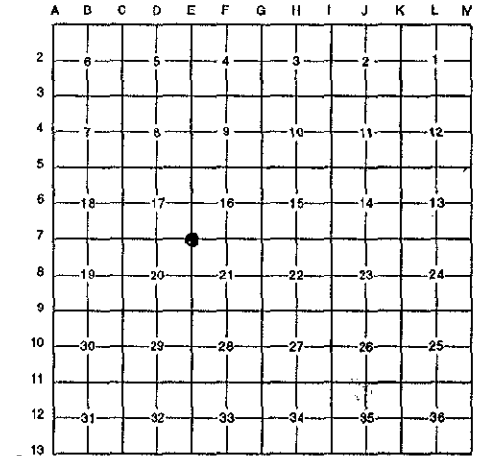

P.A. 345 1990 KENT COUNTY
 PEER APPROVED 6/26/97
 CHAIRMAN Randy Kolehouse

This corner was originally approved by the Kent County Remonumentation Peer Group and monumented by Rob Jonker on 11/11/81 and was recorded per L.C.R.C. #2371.

B. Description of corner evidence found and/or method applied in restoring or reestablishing corner:

E-7 Found a Standard Kent County Monument on the C/L of Egypt Valley Avenue (bit.) running North and South on line of a fence line running West per L.C.R.C.'s #2371 and #6296 as set by Rob Jonker in place of a 1" iron he found at grade over a 3/4" iron 22" below grade which checked L.C.R.C. #1251 and the K.C. Surveyor's records.

L.C.R.C. #2371

L.C.R.C. #6296

Remon. tag on S side corner fence post N85°W 29.70'
 Remon. tag on NW side 16" Oak N50°E 45.01'
 Remon. tag on S side 14" Oak S73°E 46.66'
 Remon. tag on NE side 14" Oak S36°E 49.18'
 On C/L N-S pavement, in line fence to W.


Nail & Tag E sd. P.P. N 21 W 62.03'
 Nail & Tag S sd. 18" Oak S 76 E 46.54' (m. 46.67')
 Nail & Tag S sd. U.P. S 65 E 31.75' (m. 31.73')
 Nail & Tag NE sd. 18" Oak S 43 E 49.19'
 Nail & Tag SE sd. 24" Oak S 40 W 93.89'
 On Centerline N-S Bit. in line Fnc. to W.

The selected location is accepted by me and is generally accepted by professional surveyors as the best available evidence of the position of the original corner.

C. Description of monument for corner and accessories established to perpetuate locating the position of the corner:

E-7 Standard Kent County Monument

- Nail & K.C. remon. tag on E side P. pole N 21° W 62.03'
- Nail & K.C. remon. tag on S side 18" Oak S 76° E 46.67'
- Nail & K.C. remon. tag on S side Util. pole S 65° E 31.73'
- Nail & K.C. remon. tag on NE side 18" Oak S 43° E 49.19'
- Nail & K.C. remon. tag on SE side 24" Oak S 40° W 93.89'

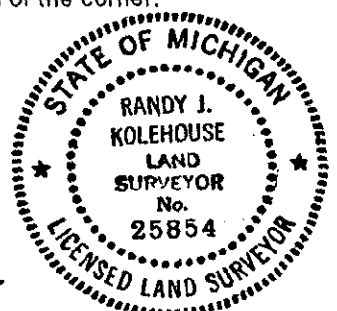

Signed by Randy J. Kolehouse Date 8/12/97

Surveyor's Michigan License No. 25854