

SURVEY & REMONUMENTATION

MAR 03 1998

LAND CORNER RECORDATION CERTIFICATE Filing Requirement of Act 74, Mich. P.A. 1970 KENT COUNTY REMONUMENTATION

SECTION
For corners in

Kent (County)	Located in: Cannon Township	Corner Code #
1. Public Land Survey	T <u>8N</u> R <u>10W</u>	<u>E-9</u>
	T _____ R _____	_____
	T _____ R _____	_____
	T _____ R _____	_____
2. Property Controlling in Section	S _____ T _____ R _____	_____
	S _____ T _____ R _____	_____
3. Miscellaneous Property in Sec.	S _____ T _____ R _____	_____
	S _____ T _____ R _____	_____
4. Lot No. _____, Recorded Plat _____		
5. Private Claims _____		

REG. OF DEEDS

Lucy Bond

97 OCT 15 AM 8:45

STATE OF MICHIGAN
COUNTY OF KENT
RECEIVED FOR RECORD

10103

Register of Deeds Stamp & File Number

I, Randy Kolehouse, in a field survey on June 11 19 97, do hereby certify that under requirements of P.A. 74 Michigan P.A. of 1970, the corner points mentioned in lines 1 and 2 above were in conformance with regulations and rules therefore as required in the current manual of survey instructions of the United States Department of the Interior, Bureau of Land Management or by a decree of a Court of Law and/or that the corner points mentioned in lines 3, 4 and 5 above were in conformance with the rules of the Michigan Board of Land Surveyors or by a Decree of a Court of Law; established, re-established, monumented, re-monumented, recovered, found as expressed below:

NOTE: Not more than 4 corners, all in the same town and range, may be recorded on this certificate.

A. Description of original monument and accessories and/or subsequent restoration:

E-9	1831	G.L.O. Notes	Mullett	Set Post
	N/A	Witness Map	K.C. Surveyor	Iron
	1977	L.C.R.C. #1096	Glaza & Associates	3/4" Pipe in Mon. Box
	1980	L.C.R.C. #1340	Williams & Works	5/8" Iron in Mon. Box
	1982	L.C.R.C. #3076	Jonker Land Surveys	Fnd. 5/8" Iron in Mon. Box / Set K.C. Monument
	1992	L.C.R.C. #6298	Chris Marschall	K.C. Monument

This corner was originally approved by the Kent County Remonumentation Peer Group and monumented by Rob Jonker on 8/4/82 and was recorded per L.C.R.C. #3076.

B. Description of corner evidence found and/or method applied in restoring or reestablishing corner:

E-9 Found a Standard Kent County Monument in the C/L of Egypt Valley Avenue (bit.) running North and South and 50' ± South of the C/L of Cannonsburg Road (bit.) running East and West per L.C.R.C.'s #3076 and #6298 as set by Rob Jonker in place of a 3/4" iron he found which checked L.C.R.C.'s #1340, #1096 and the K.C. Surveyor's records.

L.C.R.C. #3076

Set chisled "X" on curb joint N35°E 83.35'
C/L Man Hole N05°E 104.58'
C/L Cannonsburg Road N 54'

L.C.R.C. #6298

Nail & Tag N sd. U.P. S 81 E 49.36'
NE corner conc. 8' x 6' slab (Top) S 89 W 51.02'
"X" Chisled top 24" conc. culvert S 77 E 86.06'
On C/L N-S Bit.
C/L Cannonsburg Rd. N more or less 54'

The selected location is accepted by me and is generally accepted by professional surveyors as the best available evidence of the position of the original corner.

C. Description of monument for corner and accessories established to perpetuate locating the position of the corner:


E-9 Standard Kent County Monument

Nail & K.C. remon. tag on N side Util. pole S 81° E 49.36'
NE cor. conc. slab (top) S 89° W 51.02'
Chisled "X" top 24" conc. culvert S 77° E 86.06'
Chisled "X" on curb joint N 35° E 83.35'
C/L M.H. N 05° E 104.58'

P.A. 345 1990 KENT COUNTY

PEER APPROVED 6/26/97

CHAIRMAN Harry Huber

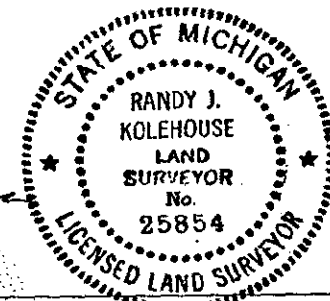

Signed by

Randy J. Kolehouse
EARTH TECH

Date

8/12/97

Surveyor's Michigan License No.

25854