

SURVEY & REMONUMENTATION

MAR 03 1998

LAND CORNER RECORDATION CERTIFICATE Filing Requirement of Act 74, Mich. P.A. 1970 KENT COUNTY REMONUMENTATION

STATE OF MICHIGAN
 COUNTY OF KENT
 RECEIVED FOR RECORD
 97 OCT 15 AM 8:45
 REG. OF DEEDS
Lucy St. Bernard

For corners in SECTION

Kent (County)	Located in: Cannon Township	Corner Code #
1. Public Land Survey	T <u>8N</u> R <u>10W</u>	<u>E-10</u>
	T _____ R _____	_____
	T _____ R _____	_____
	T _____ R _____	_____
2. Property Controlling in Section	S _____ T _____ R _____	_____
	S _____ T _____ R _____	_____
3. Miscellaneous Property in Sec.	S _____ T _____ R _____	_____
	S _____ T _____ R _____	_____
4. Lot No. _____, Recorded Plat _____		
5. Private Claims _____		

10104


Register of Deeds Stamp & File Number

I, Randy Kolehouse, in a field survey on June 11 19 97, do hereby certify that under requirements of P.A. 74 Michigan P.A. of 1970, the corner points mentioned in lines 1 and 2 above were in conformance with regulations and rules therefore as required in the current manual of survey instructions of the United States Department of the interior, Bureau of Land Management or by a decree of a Court of Law and/or that the corner points mentioned in lines 3, 4 and 5 above were in conformance with the rules of the Michigan Board of Land Surveyors or by a Decree of a Court of Law; established, re-established, monumented, re-monumented, recovered, found as expressed below:

NOTE: Not more than 4 corners, all in the same town and range, may be recorded on this certificate.

A. Description of original monument and accessories and/or subsequent restoration:

E-10	1831	G.L.O. Notes	Mullett	Set Post
		Witness Map	K.C. Surveyor	N/A
	1980	L.C.R.C. #1340	Williams & Works	"T" Iron
	1981	L.C.R.C. #2372	Jonker Land Surveys	Fnd. "T" Iron / Set K.C. Monument
	1992	L.C.R.C. #6299	Chris Marschall	K.C. Monument

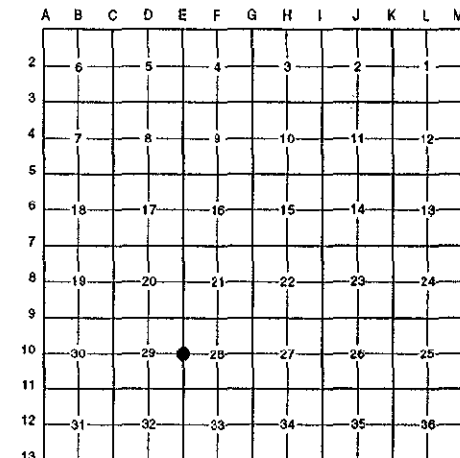

P.A. 345 1990 KENT COUNTY
 PEER APPROVED 6/26/97
 CHAIRMAN *[Signature]*
 K.C. Monument

This corner was originally approved by the Kent County Remonumentation Peer Group and monumented by Rob Jonker on 11/11/81 and was recorded per L.C.R.C. #2372.

B. Description of corner evidence found and/or method applied in restoring or reestablishing corner:

E-10 Found a Standard Kent County Monument 1' West of the C/L of Egypt Valley Avenue (bit.) running North and South per L.C.R.C.'s #2372 and #6299 as set by Rob Jonker in place of a "T" iron he found at grade over a 3/4" iron 16" below grade which checked L.C.R.C. #1340 and the K.C. Surveyor's records.

L.C.R.C. #2372

- Remon. tag on NW side 16" Oak N46°E 36.54'
- Remon. tag on S side 16" Oak N75°W 39.64'
- Remon. tag on NE side 12" Maple S 41° E 30.10'
- Remon. tag on NW side 10" Oak S 52° W 29.98'

L.C.R.C. #6299

- Nail & tag NW sd. 23" Oak N 41 E 36.56'
- Nail & tag S sd. U.P. S 89 E 63.06'
- Nail & tag SW sd. Twin 10" Maple S 43 E 56.59'
- Nail & Tag SE sd. 18" Oak S 48 W 47.00'

The selected location is accepted by me and is generally accepted by professional surveyors as the best available evidence of the position of the original corner.

C. Description of monument for corner and accessories established to perpetuate locating the position of the corner:

E-10 Standard Kent County Monument

- Nail & K.C. remon. tag on NW side 22" Oak N 41° E 36.56'
- Nail & K.C. remon. tag on S side Util. pole S 89° E 63.06'
- Nail & K.C. remon. tag on SW side Twin 10" Maple S 47° E 56.59'
- Nail & K.C. remon. tag on N side 14" Oak N 90° W 38.02'

Signed by *Randy J. Kolehouse* Date 8/12/97
 EARTH TECH
 Surveyor's Michigan License No. 25854

