

**SURVEY & REMONUMENTATION**

**MAR 03 1998**

**SECTION**

**LAND CORNER RECORDATION CERTIFICATE  
Filing Requirement of Act 74, Mich. P.A. 1970  
KENT COUNTY REMONUMENTATION**

For corners in

Kent (County)	Located in: Cannon Township	Corner Code #
1. Public Land Survey	T <u>8N</u> R <u>10W</u>	<u>E-11</u>
	T _____ R _____	_____
	T _____ R _____	_____
	T _____ R _____	_____
2. Property Controlling in Section	S _____ T _____ R _____	_____
	S _____ T _____ R _____	_____
3. Miscellaneous Property in Sec.	S _____ T _____ R _____	_____
	S _____ T _____ R _____	_____

REG. OF DEEDS

*Lucy Spauld*

97 OCT 15 AM 8:45

STATE OF MICHIGAN  
COUNTY OF KENT  
RECEIVED FOR RECORD

**10105**

Register of Deeds Stamp & File Number


4. Lot No. \_\_\_\_\_, Recorded Plat \_\_\_\_\_  
5. Private Claims \_\_\_\_\_

I, Randy Kolehouse, in a field survey on June 11 19 97, do hereby certify that under requirements of P.A. 74 Michigan P.A. of 1970, the corner points mentioned in lines 1 and 2 above were in conformance with regulations and rules therefore as required in the current manual of survey instructions of the United States Department of the interior, Bureau of Land Management or by a decree of a Court of Law and/or that the corner points mentioned in lines 3, 4 and 5 above were in conformance with the rules of the Michigan Board of Land Surveyors or by a Decree of a Court of Law; established, re-established, monumented, re-monumented, recovered, found as expressed below:

**NOTE: Not more than 4 corners, all in the same town and range, may be recorded on this certificate.**

**A. Description of original monument and accessories and/or subsequent restoration:**

E-11	1831	G.L.O. Notes	Mullett	Set Post
	N/A	Witness Map	K.C. Surveyor	3/4" Iron
	1972	L.C.R.C. #231	Williams & Works	3/4" Iron
	1981	L.C.R.C. #2433	Jonker Land Surveys	Fnd. 3/4" Iron / Set K.C. Monument
	1992	L.C.R.C. #6300	Chris Marschall	K.C. Monument

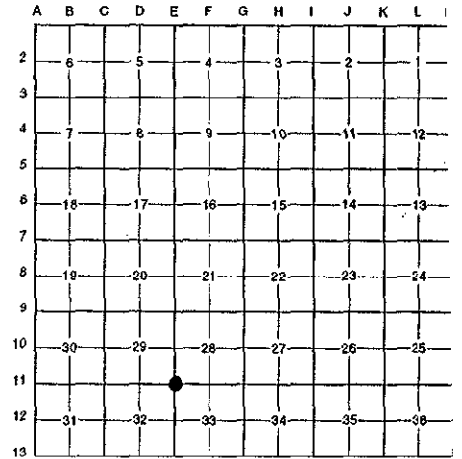

P.A. 345 1990 KENT COUNTY

PEER APPROVED 6/26/97  
CHAIRMAN Randy Kolehouse

This corner was originally approved by the Kent County Remonumentation Peer Group and monumented by Rob Jonker on 12/1/81 and was recorded per L.C.R.C. #2433.

**B. Description of corner evidence found and/or method applied in restoring or reestablishing corner:**

E-11 Found a Standard Kent County Monument at the C/L intersection of Egypt Valley Avenue (bit.) running North and South and 5 Mile Road (bit.) running East and West per L.C.R.C.'s #2433 and #6300 as set by Rob Jonker in place of a 3/4" iron he found at grade over a 1" iron 12" below grade which checked L.C.R.C. #231 and the K.C. Surveyor's records.

L.C.R.C. #2433

Remon. tag on N side 16" Walnut N72°W 89.64'  
Remon. tag on NW side 18" Oak S60°W 72.90'

L.C.R.C. #6300

Nail & tag NW sd. 24" Oak S 60° W 72.69'  
Nail & tag N sd. 20" Walnut N 72° W 89.60'  
Nail & tag E sd. U.P. N 20° W 156.06'  
Nail & tag W sd. U.P. N 25° E 155.90'

The selected location is accepted by me and is generally accepted by professional surveyors as the best available evidence of the position of the original corner.

**C. Description of monument for corner and accessories established to perpetuate locating the position of the corner:**

E-11 Standard Kent County Monument

- Nail & K.C. remon. tag on NW side 24" Oak S 60° W 72.69'
- Nail & K.C. remon. tag on N side 20" Walnut N 72° W 89.60'
- Nail & K.C. remon. tag on E side Util. pole N 20° W 156.06'
- Nail & K.C. remon. tag on W side Util. pole N 25° E 155.90'

Signed by Randy J. Kolehouse  
EARTH TECH

Date 8/12/97

Surveyor's Michigan License No. 25854

