

SURVEY & REMONUMENTATION

MAR 03 1998

SECTION

LAND CORNER RECORDATION CERTIFICATE
Filing Requirement of Act 74, Mich. P.A. 1970
KENT COUNTY REMONUMENTATION

For corners in

Kent (County)	Located in: Cannon Township	Corner Code #
1. Public Land Survey	T <u>8N</u> R <u>10W</u>	<u>E-12</u>
	T _____ R _____	_____
	T _____ R _____	_____
	T _____ R _____	_____
2. Property Controlling in Section	S _____ T _____ R _____	_____
	S _____ T _____ R _____	_____
3. Miscellaneous Property in Sec.	S _____ T _____ R _____	_____
	S _____ T _____ R _____	_____

STATE OF MICHIGAN
 COUNTY OF KENT
 RECEIVED FOR RECORD

97 OCT 15 AM 8:45

REG. OF DEEDS


Lucy Standa

10106

Register of Deeds Stamp & File Number

4. Lot No. _____, Recorded Plat _____
 5. Private Claims _____

I, Randy Kolehouse, in a field survey on June 11 19 97, do hereby certify that under requirements of P.A. 74 Michigan P.A. of 1970, the corner points mentioned in lines 1 and 2 above were in conformance with regulations and rules therefore as required in the current manual of survey instructions of the United States Department of the Interior, Bureau of Land Management or by a decree of a Court of Law and/or that the corner points mentioned in lines 3, 4 and 5 above were in conformance with the rules of the Michigan Board of Land Surveyors or by a Decree of a Court of Law; established, re-established, monumented, re-monumented, recovered, found as expressed below:

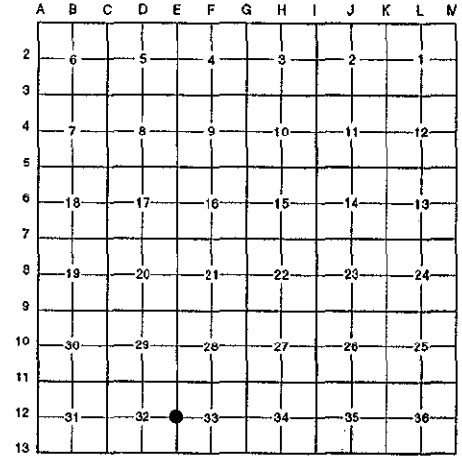

NOTE: Not more than 4 corners, all in the same town and range, may be recorded on this certificate.

A. Description of original monument and accessories and/or subsequent restoration:

Date	Description	Surveyor	Monument
E-12 1831	G.L.O. Notes	Mullett	Set Post
N/A	Witness Map	K.C. Surveyor	Iron & Stone
1981	L.C.R.C. #1954	Exxel Engineering	"T" Iron
1982	L.C.R.C. #2959	Williams & Works	Fnd. "T" Iron / Set K.C. Monument
1992	L.C.R.C. #6301	Chris Marschall	K.C. Monument

This corner was originally approved by the Kent County Remonumentation Peer Group and monumented by Williams & Works on 7/2/82 and was recorded per L.C.R.C. #2959.

B. Description of corner evidence found and/or method applied in restoring or reestablishing corner:

E-12 Found a Standard Kent County Monument on the C/L of Egypt Valley Avenue (bit.) running North and South on line of a fence line running West and a tree row running East per L.C.R.C. #6301 as set by Williams & Works in place of a "T" iron they found that checked L.C.R.C. #1954 and the K.C. Surveyor's records.

L.C.R.C. #6301


- Nail & Tag N sd. 10" Ash N 88 W 44.23'
- "X" chisled top 48" CMP S 31 W 52.00'
- Nail & Tag S sd. Fnc. Post S 77 W 37.74'
- Nail & Tag top 6" x 6" Fnc. Post S 22 W 99.16' (m. 99.62)
- "X" chisled top 12" CMP S 23 E 55.73'

P.A. 345 1990 KENT COUNTY
 PEER APPROVED 6/26/97
 CHAIRMAN *[Signature]*

The selected location is accepted by me and is generally accepted by professional surveyors as the best available evidence of the position of the original corner.

C. Description of monument for corner and accessories established to perpetuate locating the position of the corner:

- E-12 Standard Kent County Monument
- Nail & K.C. remon. tag on N side 10" Ash N 88° W 44.23'
 - "X" chisled on top of 48" C.M.P. S 31° W 52.00'
 - Nail & K.C. remon. tag on S side fence post S 77° W 37.74'
 - Nail & K.C. remon. tag on top of wood fence post S 22° W 99.62'
 - "X" chisled on top of 12" C.M.P. S 23° E 55.73'

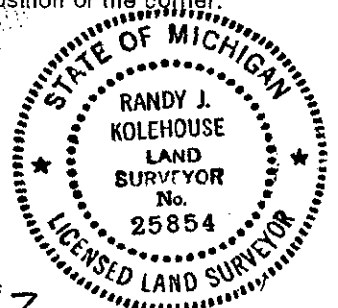

Signed by *Randy J. Kolehouse* Date 8/12/97
 EARTH TECH

Surveyor's Michigan License No. 25854