

MAR 03 1998

SECTION

LAND CORNER RECORDATION CERTIFICATE
Filing Requirement of Act 74, Mich. P.A. 1970
KENT COUNTY REMONUMENTATION

For corners in

Kent (County)

Located in: Cannon Township

Corner Code #

- 1. Public Land Survey T 8N R 10W E-13
2. Property Controlling in Section S T R
3. Miscellaneous Property in Sec. S T R

- 4. Lot No. , Recorded Plat
5. Private Claims

STATE OF MICHIGAN COUNTY OF KENT RECEIVED FOR RECORD 97 OCT 15 AM 8:45 REG. OF DEEDS

10107

Register of Deeds Stamp & File Number

I, Randy Kolehouse, in a field survey on June 11 19 97, do hereby certify that under requirements of P.A. 74 Michigan P.A. of 1970, the corner points mentioned in lines 1 and 2 above were in conformance with regulations and rules therefore as required in the current manual of survey instructions of the United States Department of the interior, Bureau of Land Management or by a decree of a Court of Law and/or that the corner points mentioned in lines 3, 4 and 5 above were in conformance with the rules of the Michigan Board of Land Surveyors or by a Decree of a Court of Law; established, re-established, monumented, re-monumented, recovered, found as expressed below:

NOTE: Not more than 4 corners, all in the same town and range, may be recorded on this certificate.

A. Description of original monument and accessories and/or subsequent restoration:

Table with 4 columns: Date (E-13 1831, 1893, 1964, 1984, 1992), Description (G.L.O. Notes, Witness Map, L.C.R.C. #3959, L.C.R.C. #6302), Name (Mullett, Williams & Works, K.C. Surveyor, Exxel Engineering, Chris Marschall), and Monument Type (Set Post, Fnd. Old Stake / Set Sleigh Shoe, Monument, Set K.C. Monument, K.C. Monument)

Note: This corner is not common with E-1, T7N, R10W.

This corner was originally approved by the Kent County Remonumentation Peer Group and monumented by Exxel Engineering on 9/27/84 and was recorded per L.C.R.C. #3959.

B. Description of corner evidence found and/or method applied in restoring or reestablishing corner:

E-13 Found a Standard Kent County Monument 12' ± North of the C/L of 4 Mile Road (gravel) running East and West and 120' East of the C/L of Egypt Valley Road (bit.) running North per L.C.R.C.'s #3959 and #6302 as set by Exxel Engineering by holding a point 264.60' East of 1" iron at E-1 of Ada Township and by holding two witnesses from the 1964 survey notes of Williams & Works.

L.C.R.C. #3959

Nail & remon tag in E sde P. Pole S29°W 112.18'
Nail & remon tag in NE sde 4" W. Cherry S36°E 52.47'
C/L gravel road to North West 114.5'±
C/L E-W gravel road South 12'±

L.C.R.C. #6302

Nail & tag NW sd. 22" Elm S 45 W 53.82' (m. 53.84')
Nail & tag E sd. P.O. (4' above grd.) S 25 W 112.24' (m. 112.30')
Nail & tag NE sd. 8" W. Cherry S 41 E 52.51'
C/L Bit. Rd. to the North (1/2" Rebar in Conc) N 90 W 114.60'

The selected location is accepted by me and is generally accepted by professional surveyors as the best available evidence of the position of the original corner.

C. Description of monument for corner and accessories established to perpetuate locating the position of the corner:


E-13 Standard Kent County Monument

- Nail & K.C. remon. tag on NW side 24" Elm S 45° W 53.84'
Nail & K.C. remon. tag on E side P. pole (4' above gnd.) S 25° W 112.30'
Nail & K.C. remon. tag on NE side 8" Cherry S 41° E 52.51'
1/2" rebar in conc. on C/L bit. rd. to the North N 90° W 114.60'
K.C. Mon. at NE corner of Sec. 5, T7N, R10W, West 264.60'

Signed by Randy J. Kolehouse EARTH TECH

Date 8/12/97

Surveyor's Michigan License No. 25854

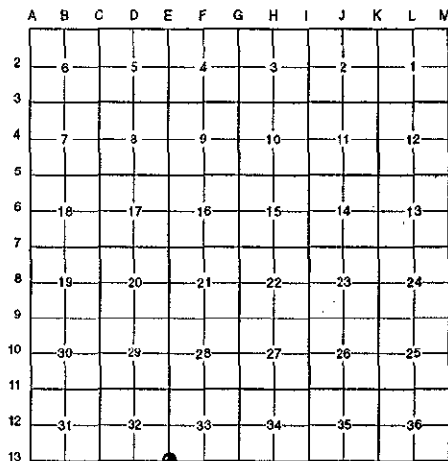

P.A. 345 1990 KENT COUNTY PEER APPROVED 6/26/97 CHAIRMAN [Signature]

