

# SURVEY & REMONUMENTATION

MAR 03 1998

## SECTION

### LAND CORNER RECORDATION CERTIFICATE Filing Requirement of Act 74, Mich. P.A. 1970 KENT COUNTY REMONUMENTATION

For corners in


Kent (County)	Located in: Cannon Township	Corner Code #
1. Public Land Survey	T <u>8N</u> R <u>10W</u>	<u>F-1</u>
	T _____ R _____	_____
	T _____ R _____	_____
	T _____ R _____	_____
2. Property Controlling In Section	S _____ T _____ R _____	_____
	S _____ T _____ R _____	_____
3. Miscellaneous Property in Sec.	S _____ T _____ R _____	_____
	S _____ T _____ R _____	_____

STATE OF MICHIGAN  
COUNTY OF KENT  
RECEIVED FOR RECORD  
97 OCT 15 AM 8:45  
REG. OF DEEDS  
*Lucy Bond*

**10108**  
Register of Deeds Stamp & File Number

4. Lot No. \_\_\_\_\_, Recorded Plat \_\_\_\_\_  
5. Private Claims \_\_\_\_\_

I, Randy Kolehouse, in a field survey on June 12 19 97, do hereby certify that under requirements of P.A. 74 Michigan P.A. of 1970, the corner points mentioned in lines 1 and 2 above were in conformance with regulations and rules therefore as required in the current manual of survey instructions of the United States Department of the interior, Bureau of Land Management or by a decree of a Court of Law and/or that the corner points mentioned in lines 3, 4 and 5 above were in conformance with the rules of the Michigan Board of Land Surveyors or by a Decree of a Court of Law; established, re-established, monumented, re-monumented, recovered, found as expressed below:

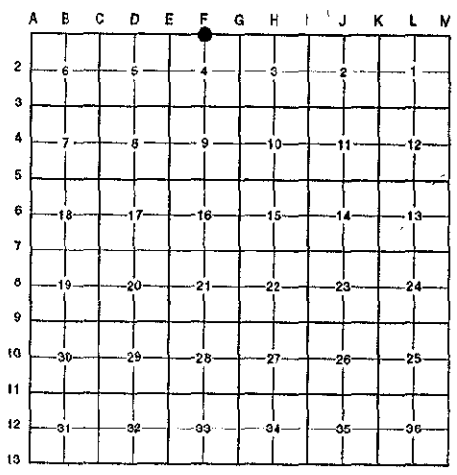

**NOTE: Not more than 4 corners, all in the same town and range, may be recorded on this certificate.**

A. Description of original monument and accessories and/or subsequent restoration:

F-1	Description	Witness Map	K.C. Surveyor	Corner Stone
	This corner was not originally set by the G.L.O.	N/A	K.C. Surveyor	Corner Stone
		1973	Williams & Works	3/4" Iron in Mon. Box
		1984	William Byl	Fnd. 1" Iron Pipe in Mon. Box / Set K.C. Monument
		1988	Olson, Meyers & May	K.C. Monument

P.A. 345 1990 KENT COUNTY  
PEER APPROVED 6/26/97  
CHAIRMAN Randy Kolehouse

Note: This corner is not common with F-13, T9N, R10W.

This corner was originally approved by the Kent County Remonumentation Peer Group and monumented by William Byl on 10/16/84 and was recorded per L.C.R.C. #3980.

B. Description of corner evidence found and/or method applied in restoring or reestablishing corner:

F-1 Found a Standard Kent County Monument on the Township line in a monument box at the C/L intersection of 10 Mile Road (bit.) running East and West and Meyers Lake Avenue (bit.) running North and South per L.C.R.C.'s #3980 and #4843 as set by William Byl in place of a 1" iron pipe he found in a monument box. Iron is 124.80' West of the South 1/4 corner of Section 33, T9N, R10W. Checked L.C.R.C. #485 and the K.C. Surveyor's records.

L.C.R.C. #3980	L.C.R.C. #4843
Nail & tag, E sd. guy pole S 55 W 64.87'	Nail & tag E sde guy pole S 55 W 64.87'
Nail & tag, W sd. guy pole N 45 E 66.06'	Nail & tag W sde guy pole N 55 E 66.06'
Nail & tag, W sd. MBT pole S 55 E 65.72'	Nail & tag W sde MBT pole S 65 E 65.72'
	F-13 Courtland (S 1/4, 33) K.C. Mon is N 90 W 124.84'

The selected location is accepted by me and is generally accepted by professional surveyors as the best available evidence of the position of the original corner.

C. Description of monument for corner and accessories established to perpetuate locating the position of the corner:

F-1 Standard Kent County Monument in a Monument Box  
Nail & K.C. remon. tag on E side Guy pole S 55° W 64.87'  
Nail & K.C. remon. tag on W side Guy pole N 55° E 66.06'  
Nail & K.C. remon. tag on W side MBT pole S 65° E 65.72'  
K.C. Mon., F-13, T9N, R10W, N 90° W 124.84'



Signed by Randy J. Kolehouse  
EARTH TECH

Date 8/12/97

Surveyor's Michigan License No. 25854